



PTT PHENOL COMPANY
LIMITED

PROCESS SPECIFICATION

PREFLASH COLUMN STEAM HEATER CONDENSATE DRUM (D-2308)

Docu. No. : 14780-8120-PS-D2308
Project No. : 120117
Rev. No. : Z1
Date : MAY 11, 2016
Page : 1 / 4

TITLE :


PREFLASH COLUMN STEAM HEATER CONDENSATE DRUM

(D-2308)

DISCIPLINE : PROCESS
DOCUMENT NO. : 14780-8120-PS-D2308
PROJECT NAME : PTT Phenol Train II Project
PROJECT NO. : 120117
OWNER : PTT Phenol Company Limited (PPCL)

Z1	MAY 11, 2016	AS BUILT		S.W.Park	J.S.Chung	- S.W.Lee
A2	DEC 11, 2013	APPROVED FOR DESIGN		S.W.Park	J.S.Chung	- S.W.Lee
A1	OCT 2, 2013	APPROVED FOR DESIGN		S.W.Park	J.S.Chung	- S.W.Lee
O1	JUN 27, 2013	COMMENT ISSUE		S.W.Park	J.S.Chung	- S.W.Lee
REV. NO.	DATE	DESCRIPTION		PREP'N	REVIEW	QA REVIEW APPROVAL
REV. NO.	PREPARATION DEPT.	PREPARATION	REVIEW	QA REVIEW		APPROVAL
Z1	PROCESS	S.W.Park	J.S.Chung	-		S.W.Lee
		MAY 11, 2016	MAY 11, 2016	-		MAY 11, 2016

This Document is the property of POSCO Engineering Co., Ltd. Therefore, it shall not be released to Any third party without permission of an authorized personnel of the POSCO Engineering Co., Ltd.

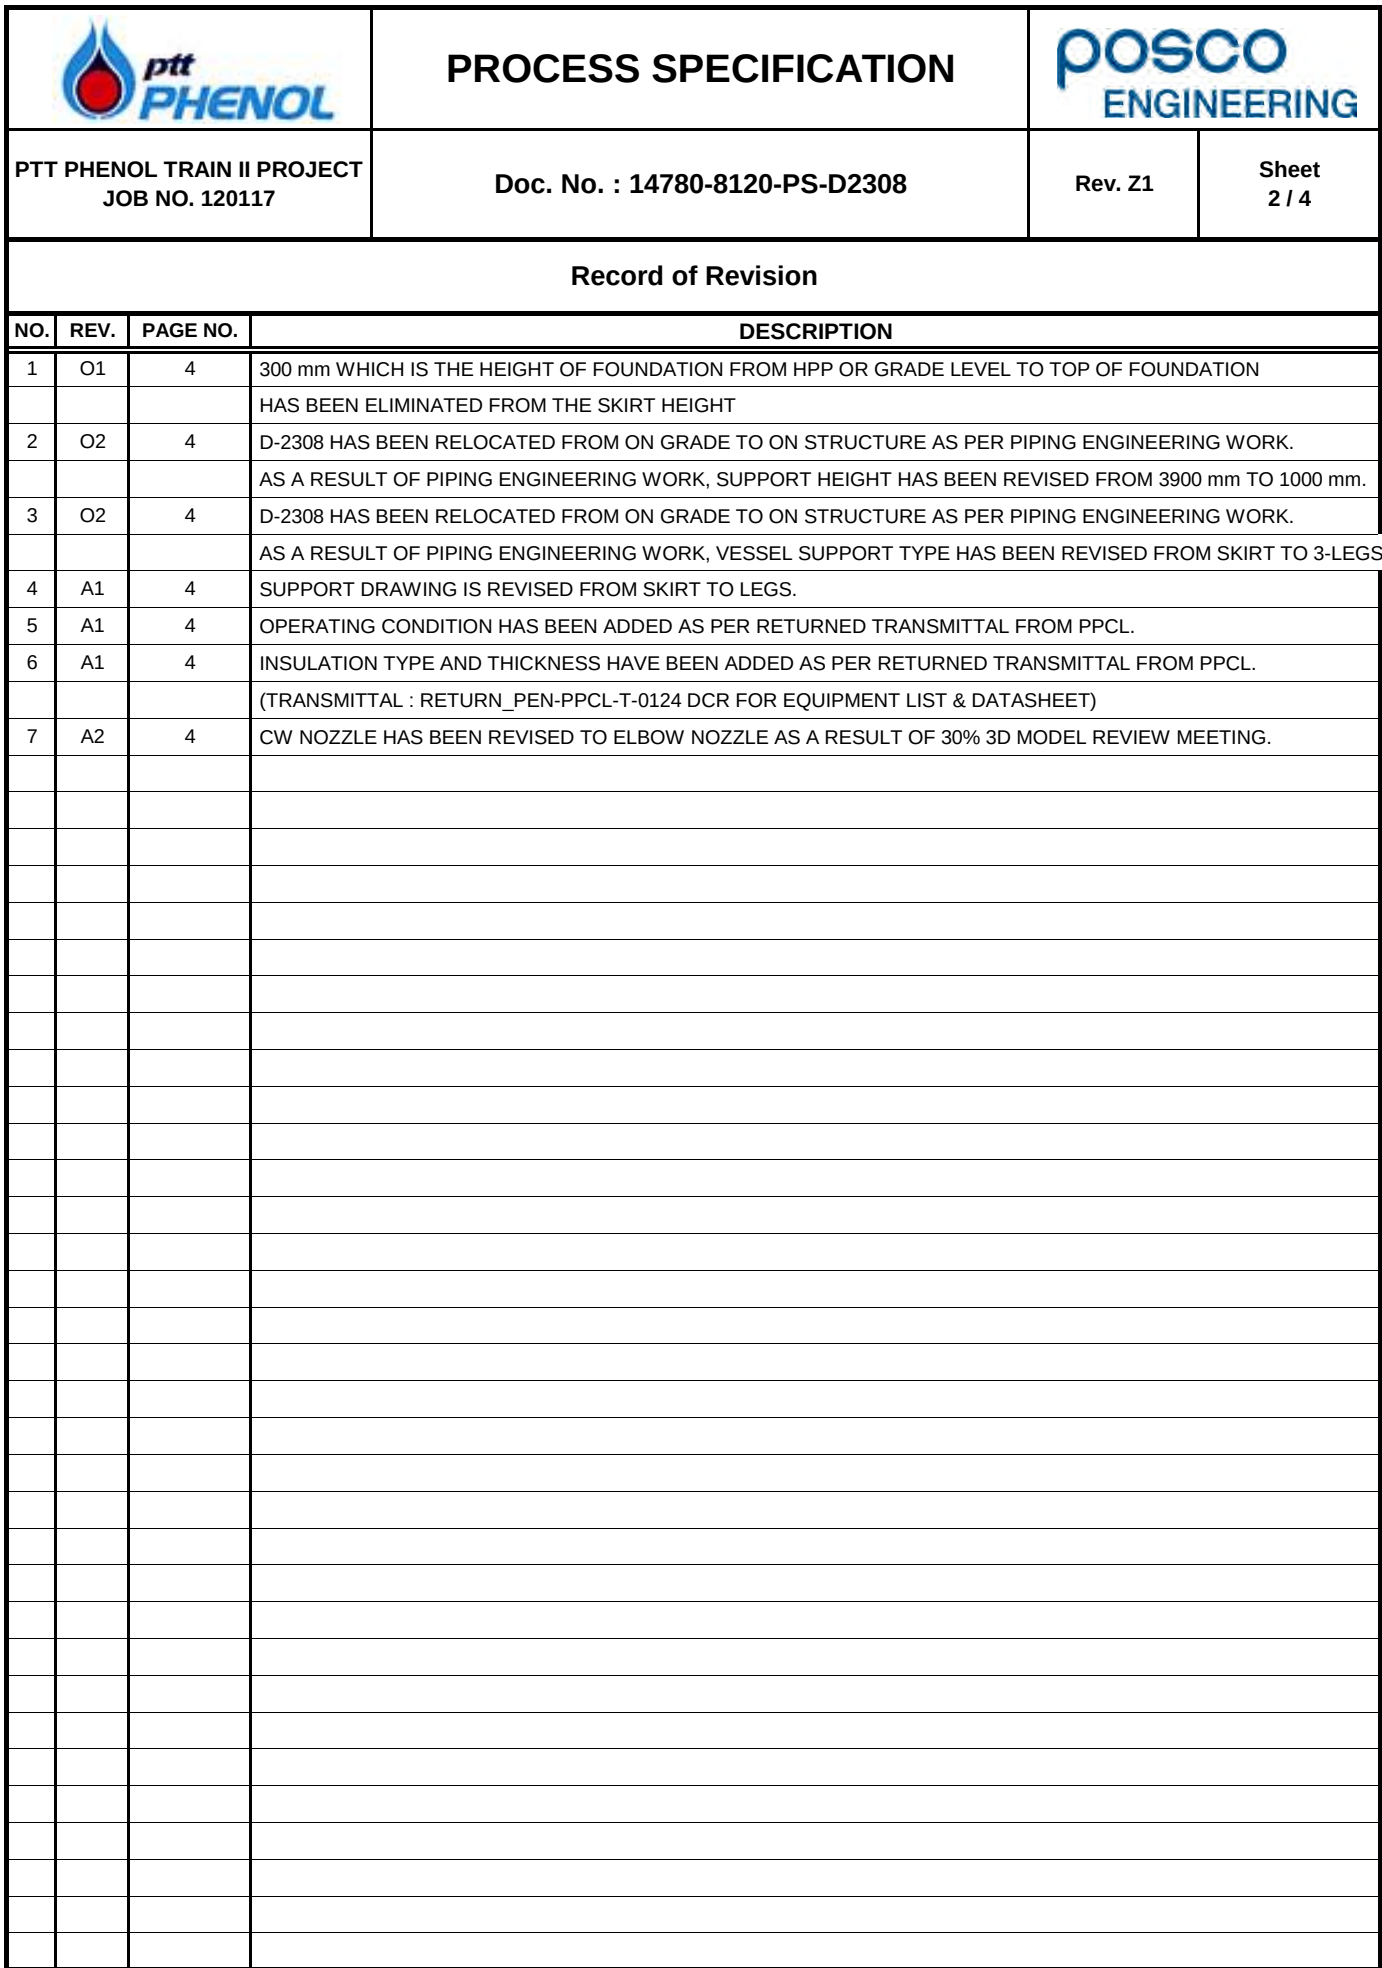

Revision
Indication



Note: The information in this document is confidential and the property of UOP LLC and must not be disclosed to others or reproduced in any manner or used for any purpose whatsoever without its written permission.



VESSELS

PROJECT SPECIFICATION

963766 — **301**

SHEET 3 / 4

REV	DATE	BY	APVD	REV	DATE	BY	APVD
0	29MAR12	JG	MYW				

General Notes

- A. Vessels shall be constructed in accordance with the following unless otherwise specified on the individual vessel specification sheet.

Standards:

UOP Standard Specification 3-11
UOP Standard Drawing 8-121

- B. Although the resulting inside diameter may be slightly different than specified, vessels without trays or packing, may be fabricated from pipe.
- C. The dimensioned location of some of the vessel level nozzles may be noted as min (minimum) or max (maximum). It is the responsibility of the contractor to adjust these dimensions to suit the specific level requirements specified on the UOP Piping and Instrument Diagram(s) and on UOP Standard Drawing 8-121. When additional nozzles are required for level instrumentation, the contractor shall specify them consistent with the size, class and facing requirements specified in the UOP Project Specification 301-Vessels and on the UOP Piping and Instrument Diagram(s).
- D. When system of measurement is metric, all dimensions are in millimeters unless noted otherwise.
- E. Contractor shall not locate TI thermowells in a downcomer. Contractor shall also ensure that TI thermowells are located to avoid interference with downcomers, weirs, distributors, collectors, baffles, chimneys, traps and all other vessel internals.

Other specifications
referenced in this
specification:

UOP Standard Specification: 3-11, 3-15

UOP Standard Drawing: 3-115, 3-122, 3-123, 3-183, 3-190, 3-272, 3-278, 3-280, 3-305, 3-313, 3-322, 8-121

UOP Project Specification: 963766-307, 963766-401, 963766-808



PROJECT SPECIFICATION

963766 - 301 SHEET 4 / 4

REV	DATE	BY	APP'D	REV	DATE	BY	APP'D
0	29MAR12	TS	MYW				
1	13AUG12	TS	MYW				

E
V

VESSLS

SERVICE PREFLASH COLUMN STEAM HEATER CONDENSATE
DRUM

ITEM NO

D-2308

Design	INT 7.0 kg/cm2(g) @ 195 °C
Conditions	EXT FULL VACUUM @ 142 °C
at Top	Metal Temperature(Min) 15 °C
Operating	142 °C
Conditions	0.9kg/cm2(g) @ 117 °C

Radiograph	MR
Postweld Heat Treat	MR

Material	Corrosion Allowance
KILLED CARBON STEEL	3

This Vessel is in the Following Service(s):

Hydrogen	NO
Hydrofluoric (HF) Acid	NO
Hydrofluoric (HF) Acid (with Resid. Elem. Control)	NO
Wet Hydrogen Sulfide (H2S)	NO
Severe Cyclic	NO
Caustic	NO
Carbonate	NO
Amine	NO
Note:	

Vessel Heads	
Top	2:1 ELLIPTICAL
Bottom	2:1 ELLIPTICAL

Accessories Applied by Fabricator	
Ladder & Platform Clips	AS REQUIRED
Insulation Clips & Rings	PP (40) YES
Vessel Support	(3-LEGS) YES

Nozzles and Manways			
Mark	No	Size Inches	Service
AM	1	VESSEL ID	MANWAY
AO	1	2	EQUALIZING
AV	1	2	VENT
BA	1	2	SPILLBACK
BB	2	8 ID	HANDHOLE
BJ	1	4	INLET
BK	2	2	LG (2)
BL	2	2	LT (2)
CW	1	4	OUTLET


Class - ASME CL150

(2) ASME CL300

Facing - RAISED FACE

Normal Liquid Level = 550 mm ABOVE
BOTTOM TANGENT

Specific Gravity = 0.97

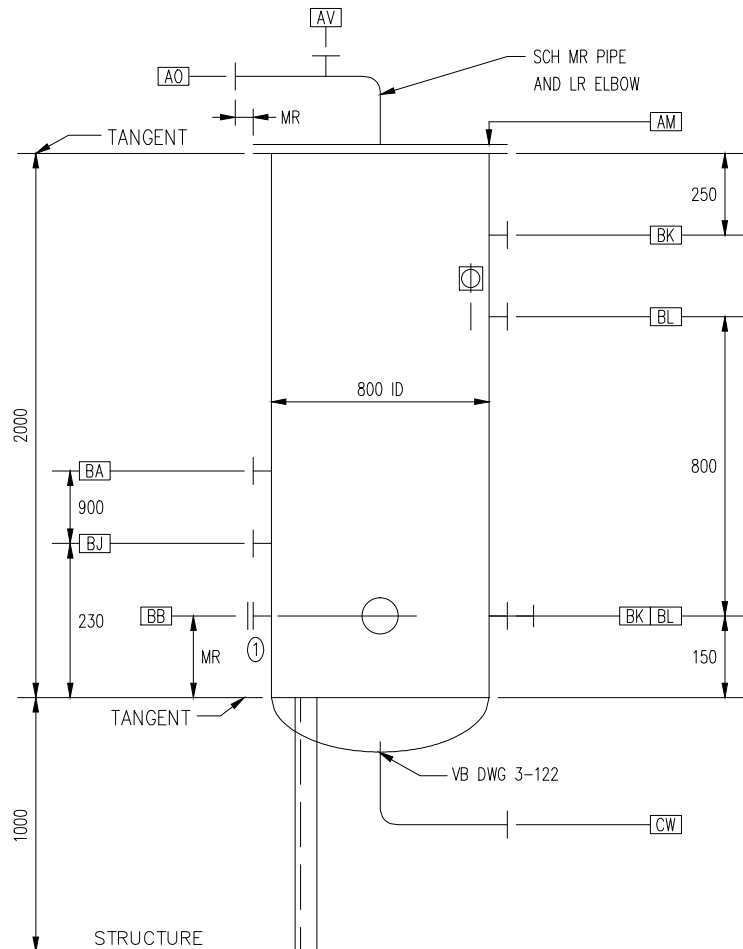

Drawings Referred to in this Specification

3-115

3-122

NOTE - The information in this document is confidential and the property of UOP LLC and must not be disclosed to others or reproduced in any manner or used for any purpose whatsoever without its written permission.