
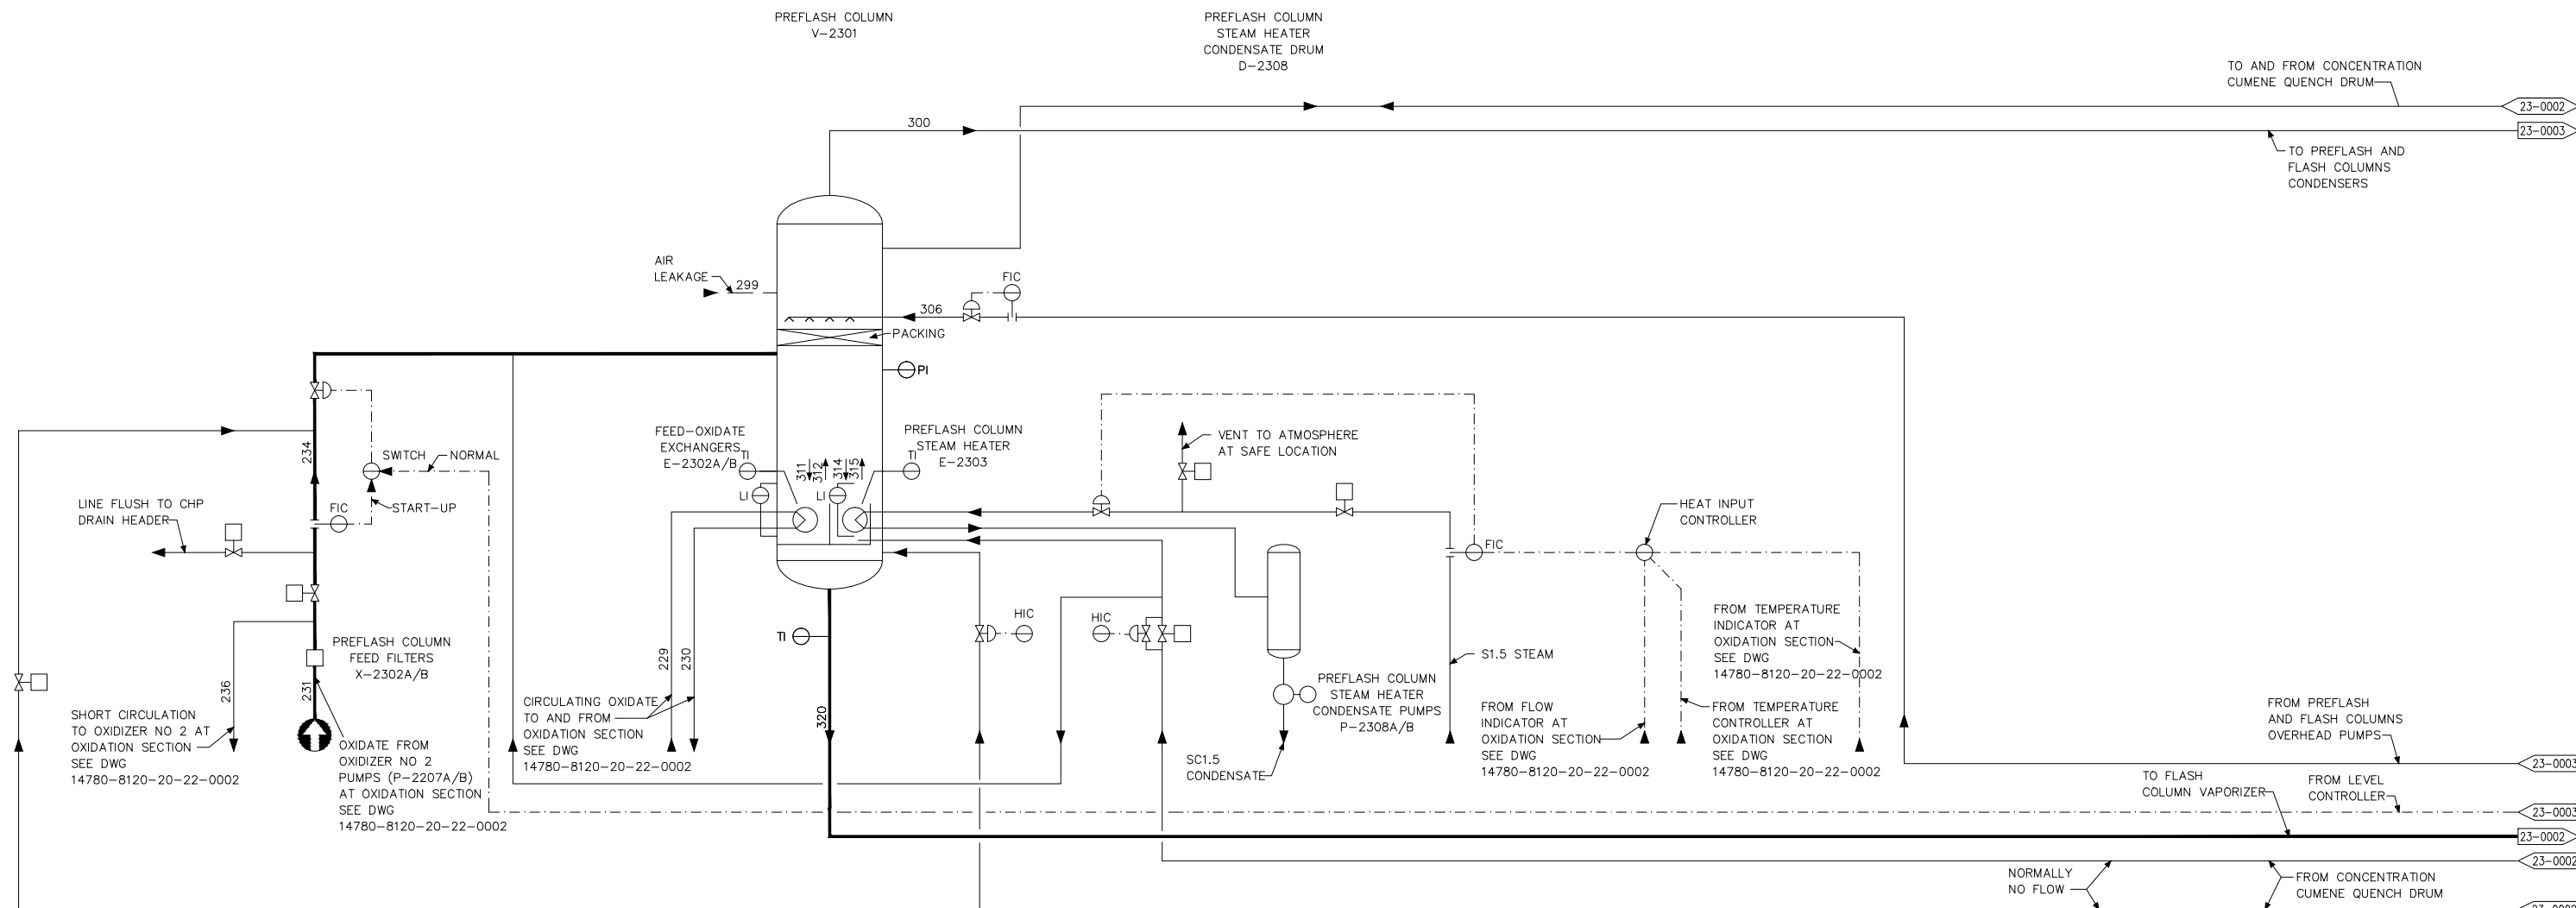


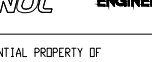

STREAM DATA SUMMARY													
STREAM NUMBER	229	230	231	234	236	299	300	306	311	312	314	315	320
TEMPERATURE, deg C	83	75	82	82	82	27	52	39	58	60	60	70	70
PRESSURE, kg/cm2(g)(mm Hg)	----	----	----	----	----	----	----	----	----	----	----	----	----
TOTAL MASS FLOW, kg/h	1076643	1076643	210868	204542	6326	6.1	138722	19396	189488	189488	149940	149940	85223

HEATER AND EXCHANGER DUTY SUMMARY		
ITEM NUMBER	E-2302 A/B	E-2303
DUTY, MM kcal/h	3.99	6.10

Z1	AS-BUILT	HSD	SWP	JSC	SWL	4/25/'16
S1	ISSUED FOR CONSTRUCTION NO HOLDS	HSD	SWP	JSC	SWL	4/25/'16
A1	APPROVED FOR DESIGN	HSD	SWP	JSC	SWL	9/12/'17
O1	COMMENT ISSUE	HSD	SWP	JSC	SWL	7/11/'18
REV.	DESCRIPTION	BY	CHK.	APPR.	PROJ. APPR.	DATE

											
THIS DRAWING IS CONFIDENTIAL PROPERTY OF PTT PHENOL COMPANY LIMITED											
AND IS LENT WITHOUT CONSIDERATION OTHER THAN THE BORROWER'S AGREEMENT. THAT IT SHALL NOT BE RE-PRODUCED, COPIED, LENT, OR DISPOSED OF DIRECTLY OR INDIRECTLY NOR USED FOR ANY PURPOSE OTHER THAN THAT FOR WHICH IT IS SPECIFICALLY FURNISHED. THE APPARATUS SHOWN IN THE DRAWING MAY BE COVERED BY PATENTS AND/OR MAY BE PROPRIETARY											
	BASED ON 963766-110-01-A1										
PROCESS FLOW DIAGRAM CUMENE QUENCH TANK-PREFLASH COLUMN CONCENTRATION SECTION CONCENTRATION AND NEUTRALIZATION SECTION UOP PROCESS UNIT											
CERTIFIED FOR CONSTRUCTION BY _____ DATE _____	BY _____ DATE _____	<table border="1" style="width: 100%; border-collapse: collapse;"> <tr> <td style="width: 15%;">DWG.</td> <td style="width: 15%;">DSGN.</td> <td style="width: 15%;">CHK.</td> <td style="width: 15%;">APPR.</td> </tr> <tr> <td style="height: 40px;"></td> <td></td> <td></td> <td></td> </tr> </table>	DWG.	DSGN.	CHK.	APPR.					
DWG.	DSGN.	CHK.	APPR.								
<table border="1" style="width: 100%; border-collapse: collapse;"> <tr> <td style="width: 25%;">PROJ. NO.</td> <td style="width: 50%;">DWG. NO.</td> <td style="width: 25%;">REV.</td> </tr> <tr> <td style="height: 40px; text-align: center;">PEN 120117</td> <td></td> <td></td> </tr> <tr> <td style="height: 40px; text-align: center;">PPCL</td> <td style="text-align: center;">14780-8120-20-23-0001</td> <td style="text-align: center; vertical-align: middle;">Z1</td> </tr> </table>	PROJ. NO.	DWG. NO.	REV.	PEN 120117			PPCL	14780-8120-20-23-0001	Z1		
PROJ. NO.	DWG. NO.	REV.									
PEN 120117											
PPCL	14780-8120-20-23-0001	Z1									
SCALE											