



THESE P AND I DIAGRAM IS DIAGRAMATIC ONLY. DESIGN OF PIPE LINES MUST BE INVESTIGATED FOR VENTING OF GAS AND VAPOR POCKETS IN PIPING AND EQUIPMENT. LOW POINTS IN PIPING, PUMPS AND EQUIPMENT FOR FREEZING AND DRAINING, AND ACCESSIBILITY OF ALL VALVES, FLANGES, INSTRUMENTS INCLUDING THERMOCOUPLES, ETC.

NOTE: THE INFORMATION IN THIS DOCUMENT IS CONFIDENTIAL AND THE PROPERTY OF UOP LLC AND MUST NOT BE DISCLOSED TO OTHERS OR REPRODUCED IN ANY MANNER OR USED FOR ANY PURPOSE WHATSOEVER WITHOUT ITS WRITTEN PERMISSION.


14780-8120-25-23-0001A

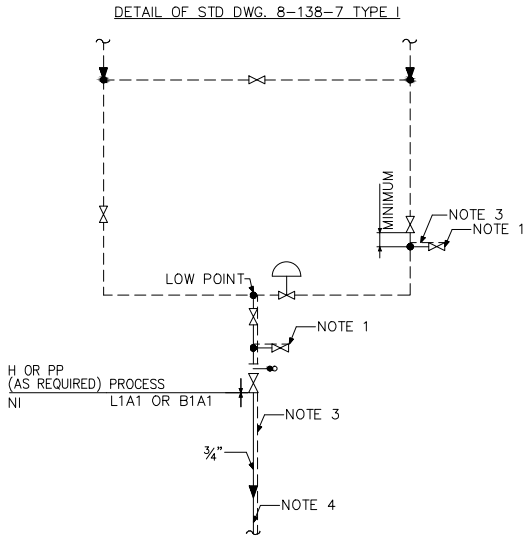

ITEM NO	P&ID NO.	DRAIN LINE NO.	DRAIN SUMP
FV-0403	14780-8120-25-23-0004	3/4"-CHD-23-004022-L1A1-NI	D-2206
LV-0601	14780-8120-25-23-0006	3/4"-CHD-23-006014-B1A1-NI	D-2206
FV-0801	14780-8120-25-23-0008	3/4"-CHD-23-008039-L1A1-NI	D-2206
LV-0803	14780-8120-25-23-0008B	3/4"-CHD-23-008040-L1A1-NI	D-2206
LV-1101	14780-8120-25-23-0011	3/4"-CHD-23-011004-B1A1-NI	D-2206
FV-1301	14780-8120-25-23-0013	3/4"-AD-23-013009-L2A1/L1A1-NI/H	D-2307
PV-1401	14780-8120-25-23-0019	3/4"-AD-23-019013-L2A1/L1A1-NI	D-2307
FV-2001	14780-8120-25-23-0020A	3/4"-AD-23-020011-L2A1/L1A1-NI	D-2307
HV-1201	14780-8120-25-23-0012A	3/4"-CUL-23-012006-B1A1-NI	D-2206

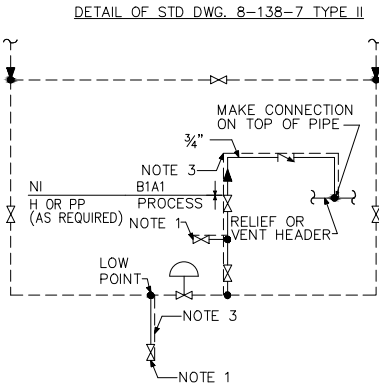

ITEM NO	P&ID NO.	VENT LINE NO.

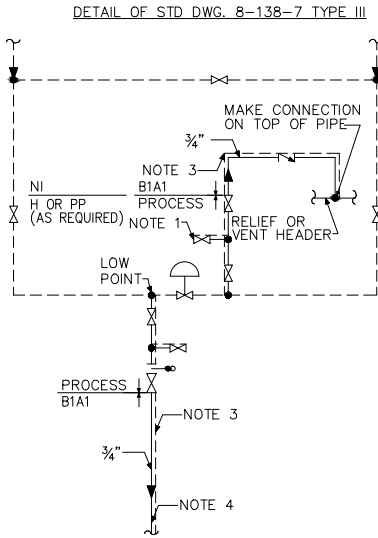

ITEM NO	P&ID NO.	CLOSED DRAIN LINE NO.	VENT LINE NO.	SUMP NO.

GENERAL NOTES

--- SHOWN ON PIPING AND INSTRUMENT DIAGRAM
=== HEAT TRACE AND INSULATE

NOTES

- 3/4" PLUGGED UTILITY CONNECTION.
- VALVES AND PIPING SHALL BE OF THE SAME METALLURGY TYPE AND CLASS AS SHOWN ON THE PIPING AND INSTRUMENT DIAGRAM.
- THE REQUIREMENTS FOR HEAT TRACING AND INSULATION AND THE OBJECTIVE TEMPERATURE SHALL BE AS SHOWN AT THE CONTROL VALVE SERVICE ON THE PIPING AND INSTRUMENT DIAGRAM.
- TO CLOSED DRAIN HEADER AND LINE NO. AS SHOWN ON TABLE.
- DELETED.



THIS DRAWING IS CONFIDENTIAL PROPERTY OF
PTT PHENOL COMPANY LIMITED

AND IS LENT WITHOUT CONSIDERATION OTHER THAN THE BORROWER'S AGREEMENT THAT IT SHALL NOT BE RE-PRODUCED, COPIED, LENT, OR DISPOSED OF DIRECTLY OR INDIRECTLY NOR USED FOR ANY PURPOSE OTHER THAN THAT FOR WHICH IT IS SPECIFICALLY FURNISHED. THE APPARATUS SHOWN IN THE DRAWING MAY BE COVERED BY PATENTS AND/OR MAY BE PROPRIETARY



BASED ON

PIPING AND INSTRUMENT DIAGRAM
DETAIL OF CONTROL VALVE VENT / DRAIN
CONCENTRATION, DECOMPOSITION AND NEUTRALIZATION
SECTION UOP PHENOL PROCESS UNIT

Z1	AS BUILT	HSO	SWP	JSC	SWL	4/25/16
S4	ISSUED FOR CONSTRUCTION NO HOLDS	HSO	SWP	JSC	SWL	10/15/14
S3	ISSUED FOR CONSTRUCTION NO HOLDS	HSO	SWP	JSC	SWL	10/8/14
S2	ISSUED FOR CONSTRUCTION NO HOLDS	HSO	SWP	JSC	SWL	9/16/14
S1	ISSUED FOR CONSTRUCTION NO HOLDS	HSO	SWP	JSC	SWL	8/20/14
R2	ISSUED FOR CONSTRUCTION WITH HOLDS	HSO	SWP	JSC	SWL	4/4/14
R1	ISSUED FOR CONSTRUCTION WITH HOLDS	HSO	SWP	JSC	SWL	2/28/14
A2	APPROVED FOR DESIGN	HSO	SWP	JSC	SWL	2/7/14
REV.	DESCRIPTION	BY	CHK.	APPR.	PROJ. APPR.	DATE

BY	DATE	DWG.	DSGN.	CHK.	APPR.
PROJ. NO.	DWG. NO.	REV.			
PEN	120117				
PPCL	14780-8120-25-23-0001A				

SCALE