


NOTE: THE INFORMATION IN THIS DOCUMENT IS CONFIDENTIAL AND THE PROPERTY OF UOP LLC AND MUST NOT BE DISCLOSED TO OTHERS OR REPRODUCED IN ANY MANNER OR USED FOR ANY PURPOSE WHATSOEVER WITHOUT ITS WRITTEN PERMISSION.

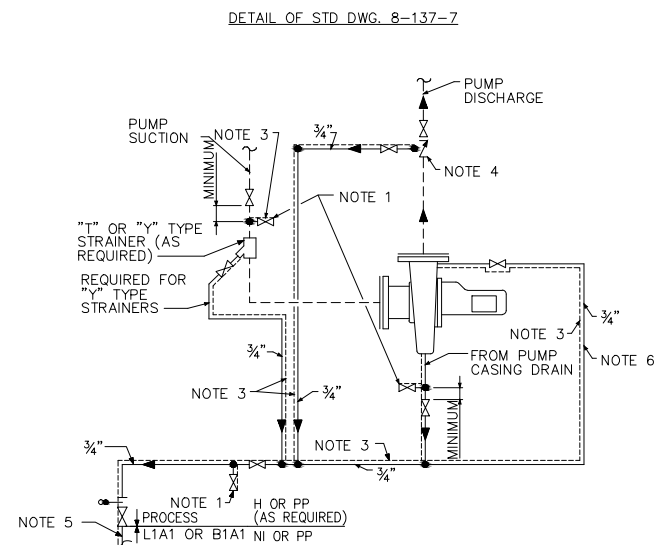

PUMP NO.	P&ID NO.	CLOSED DRAIN LINE NO.	SUMP NO.
P-2307A	14780-8120-25-23-0008B	3/4" - CHD-23-008042-L1A1-N	D-2206
P-2307B	14780-8120-25-23-0008B	3/4" - CHD-23-008043-L1A1-N	D-2206
P-2301A	14780-8120-25-23-0009	3/4" - CHD-23-009013-L1A1-N	D-2206
P-2301B	14780-8120-25-23-0009	3/4" - CHD-23-009014-L1A1-N	D-2206
P-2303A	14780-8120-25-23-0013	3/4" - AD-23-013013-L2A1/L1A1-H/PP	D-2307
P-2303B	14780-8120-25-23-0013	3/4" - AD-23-013014-L2A1/L1A1-H/PP	D-2307
P-2302A	14780-8120-25-23-0017	3/4" - AD-23-017015-L2A1/L1A1-H/PP	D-2307
P-2302B	14780-8120-25-23-0017	3/4" - AD-23-017016-L2A1/L1A1-H/PP	D-2307

--- SHOWN ON PIPING AND INSTRUMENT DIAGRAM
==== HEAT TRACE AND INSULATE

NOTES

1. 3/4" PLUGGED UTILITY CONNECTION.
2. VALVES AND PIPING SHALL BE OF THE SAME METALLURGY TYPE AND CLASS AS SHOWN ON THE PIPING AND INSTRUMENT DIAGRAM.
3. THE REQUIREMENTS FOR HEAT TRACING AND INSULATION AND THE OBJECTIVE TEMPERATURE SHALL BE AS SHOWN AT THE PUMP SERVICE ON THE PIPING AND INSTRUMENT DIAGRAM.
4. CHECK VALVE WITH CONNECTED BODY BLEED DOWNSTREAM OF FLAPPER(S) AND AT LOW POINT.
5. TO CLOSED DRAIN HEADER AND LINE NO. AS SHOWN ON TABLE.
6. REQUIRED FOR NON-SELF VENTING PUMPS.



THIS DRAWING IS CONFIDENTIAL PROPERTY OF
PTT PHENOL COMPANY LIMITED

AND IS LENT WITHOUT CONSIDERATION OTHER THAN THE BORROWER'S AGREEMENT THAT IT SHALL NOT BE RE-PRODUCED, COPIED, LENT, OR DISPOSED OF DIRECTLY OR INDIRECTLY NOR USED FOR ANY PURPOSE OTHER THAN THAT FOR WHICH IT IS SPECIFICALLY FURNISHED. THE APPARATUS SHOWN IN THE DRAWING MAY BE COVERED BY PATENTS AND/OR MAY BE PROPRIETARY



PIPING AND INSTRUMENT DIAGRAM
DETAIL OF PUMP VENT / DRAIN
CONCENTRATION, DECOMPOSITION AND NEUTRALIZATION
SECTION UOP PHENOL PROCESS UNIT

Z1	AS BUILT	HSO	SWP	JSC	SWL	4/25/16	SECTION UOP PHENOL PROCESS UNIT						
S4	ISSUED FOR CONSTRUCTION NO HOLDS	HSO	SWP	JSC	SWL	10/15/14	BY _____ DATE _____	CERTIFIED FOR CONSTRUCTION BY _____ DATE _____	DWG.	DSGN.	CHK.	APPR.	
S3	ISSUED FOR CONSTRUCTION NO HOLDS	HSO	SWP	JSC	SWL	10/8/14							
S2	ISSUED FOR CONSTRUCTION NO HOLDS	HSO	SWP	JSC	SWL	9/16/14							
S1	ISSUED FOR CONSTRUCTION NO HOLDS	HSO	SWP	JSC	SWL	8/20/14							
R2	ISSUED FOR CONSTRUCTION WITH HOLDS	HSO	SWP	JSC	SWL	4/4/14		PROJ. NO.	DWG. NO.		REV.		
R1	ISSUED FOR CONSTRUCTION WITH HOLDS	HSO	SWP	JSC	SWL	2/28/14	PEN	120117	Z1				
A2	APPROVED FOR DESIGN	HSO	SWP	JSC	SWL	2/7/14	PPCL	14780-8120-25-23-0001C					
REV.	DESCRIPTION	BY	CHK.	APPR.	PROJ. APPR.	DATE							

SCALE