


TYPICAL PUMP SEAL PLAN

API PLAN 11/53A WITH PRESSURIZED DUAL
FOR EACH SEAL FLUSHING SYSTEM

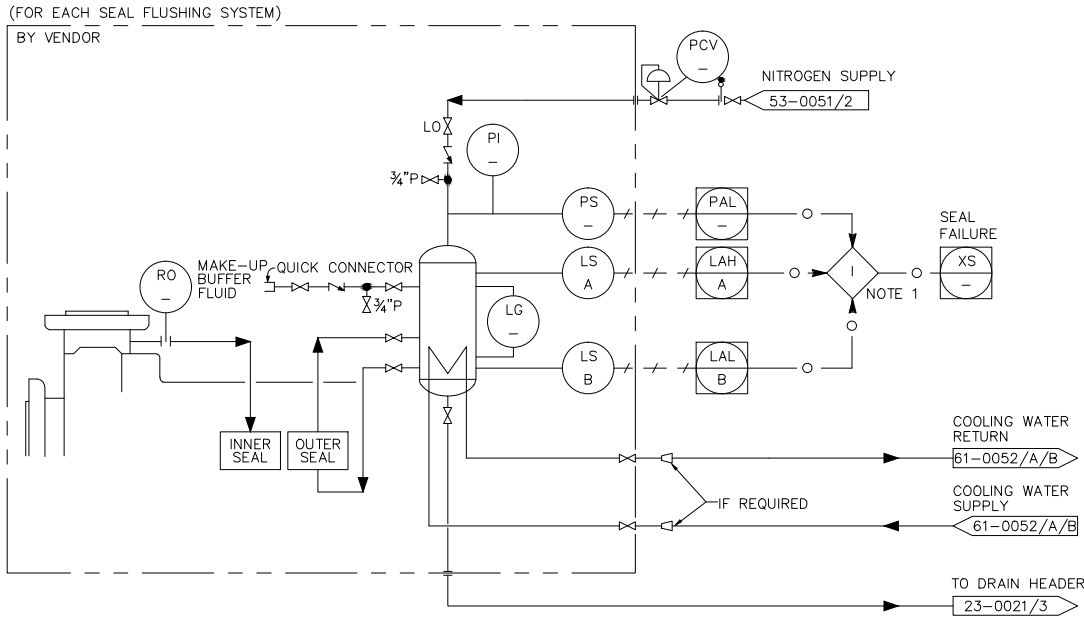

ITEM TAG NO.	P&ID NO.	COOLING WATER SUPPLY LINE NO.	COOLING WATER RETURN LINE NO.	NITROGEN SUPPLY LINE NO.	DRAIN LINE NO.	RO	LG	LS-A	LAH	LS-B	LAL	PI	PS	PAL	PCV	XS
P-2301A	14780-8120-25-23-0009	1 1/2"-RCS-61-054040-MS1-NI	1 1/2"-RCR-61-054041-MS1-NI	3/4"-N-53-052085-B1A1-NI	3/4"-CHD-23-009015-L1A1-NI	23-0902	23-0901			23-0902	23-0902	23-0903	23-0904	23-0904	23-0901	23-0901
P-2301B	14780-8120-25-23-0009	1 1/2"-RCS-61-054042-MS1-NI	1 1/2"-RCR-61-054043-MS1-NI	3/4"-N-53-052086-B1A1-NI	3/4"-CHD-23-009016-L1A1-NI	23-0903	23-0903			23-0904	23-0904	23-0905	23-0906	23-0906	23-0902	23-0901
P-2307A	14780-8120-25-23-0008B	1"-CWS-61-052148-MS1-NI	1"-CWR-61-052149-MS1-NI	3/4"-N-53-052128-B1A1-NI	3/4"-CHD-23-008044-L1A1-NI	23-0802	23-0805			23-0806	23-0806	23-0809	23-0810	23-0810	23-0801	23-0801
P-2307B	14780-8120-25-23-0008B	1"-CWS-61-052150-MS1-NI	1"-CWR-61-052151-MS1-NI	3/4"-N-53-052127-B1A1-NI	3/4"-CHD-23-008045-L1A1-NI	23-0803	23-0807			23-0808	23-0808	23-0811	23-0812	23-0812	23-0802	23-0801

GENERAL NOTES

NOTES

1. DCS LOGIC FOR SEAL FAILURE COMMON ALARM AND THIS ALARM WILL BE ACTIVATED IN CASE OF SEAL FAILURE OF OPERATION PUMP OR SPARE PUMP.



THIS DRAWING IS CONFIDENTIAL PROPERTY OF
PTT PHENOL COMPANY LIMITED

AND IS LENT WITHOUT CONSIDERATION OTHER THAN THE BORROWER'S AGREEMENT
THAT IT SHALL NOT BE RE-PRODUCED, COPIED, LENT, OR DISPOSED OF DIRECTLY OR
INDIRECTLY NOR USED FOR ANY PURPOSE OTHER THAN THAT FOR WHICH IT IS
SPECIFICALLY FURNISHED. THE APPARATUS SHOWN IN THE DRAWING MAY BE COVERED
BY PATENTS AND/OR MAY BE PROPRIETARY



BASED ON

PIPING AND INSTRUMENT DIAGRAM
TYPICAL PUMP SEAL PLAN (2/4)
CONCENTRATION, DECOMPOSITION, AND
NEUTRALIZATION SECTION
UOP PHENOL PROCESS UNIT

CERTIFIED FOR
CONSTRUCTION

BY

DATE

DWG.

DSGN.

CHK.

APPR.

PROJ. NO.

DWG. NO.

REV.

PEN

120117

Z1

PPCL

14780-8120-25-23-0001J

SCALE

Z1	AS BUILT	HSO	SWP	JSC	SWL	4/25/16
S4	ISSUED FOR CONSTRUCTION NO HOLDS	HSO	SWP	JSC	SWL	10/15/14
S3	ISSUED FOR CONSTRUCTION NO HOLDS	HSO	SWP	JSC	SWL	10/8/14
S2	ISSUED FOR CONSTRUCTION NO HOLDS	HSO	SWP	JSC	SWL	9/16/14
S1	ISSUED FOR CONSTRUCTION NO HOLDS	HSO	SWP	JSC	SWL	8/20/14
R2	ISSUED FOR CONSTRUCTION WITH HOLDS	HSO	SWP	JSC	SWL	4/4/14
R1	ISSUED FOR CONSTRUCTION WITH HOLDS	HSO	SWP	JSC	SWL	2/28/14
A2	APPROVED FOR DESIGN	HSO	SWP	JSC	SWL	2/7/14
REV.	DESCRIPTION	BY	CHK.	APPR.	PROJ. APPR.	DATE