


TYPICAL PUMP SEAL PLAN

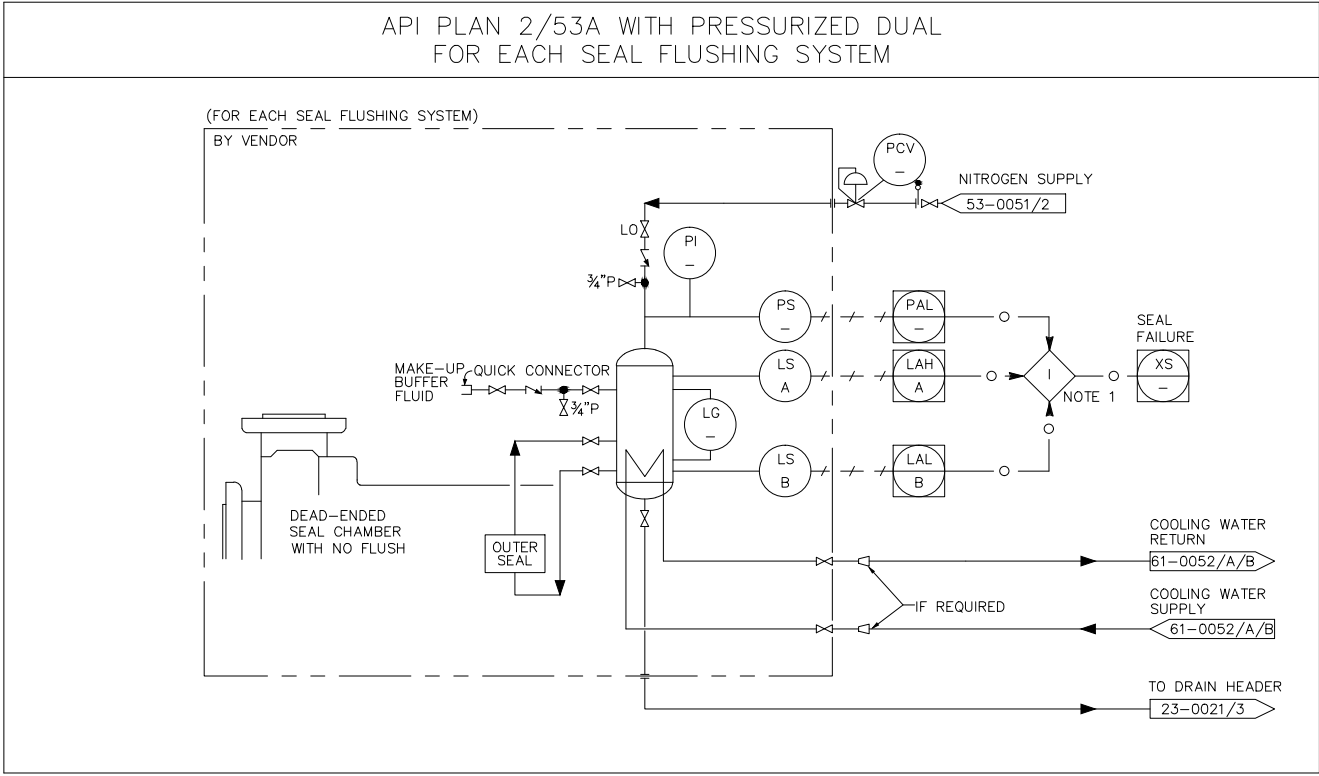

ITEM TAG NO.	P&ID NO.	COOLING WATER SUPPLY LINE NO.	COOLING WATER RETURN LINE NO.	NITROGEN SUPPLY LINE NO.	DRAIN LINE NO.	RO	LG	LS-A	LAH	LS-B	LAL	PI	PS	PAL	PCV	XS
P-2303A	14780-8120-25-23-0013	1"-CWS-61-052136-MS1-NI	1"-CWR-61-052137-MS1-NI	3/4"-N-53-053007-B1A1-NI	3/4"-AD-23-013011-L1A1-NI	-	23-1305	-	-	23-1306	23-1306	23-1306	23-1307	23-1307	23-1302	23-1301
P-2303B	14780-8120-25-23-0013	1"-CWS-61-052138-MS1-NI	1"-CWR-61-052139-MS1-NI	3/4"-N-53-053008-B1A1-NI	3/4"-AD-23-013012-L1A1-NI	-	23-1307	-	-	23-1308	23-1308	23-1308	23-1309	23-1309	23-1303	23-1301

GENERAL NOTES

1. DCS LOGIC FOR SEAL FAILURE COMMON ALARM AND THIS ALARM WILL BE ACTIVATED IN CASE OF SEAL FAILURE OF OPERATION PUMP OR SPARE PUMP.



THIS DRAWING IS CONFIDENTIAL PROPERTY OF PTT PHENOL COMPANY LIMITED

AND IS LENT WITHOUT CONSIDERATION OTHER THAN THE BORROWER'S AGREEMENT THAT IT SHALL NOT BE RE-PRODUCED, COPIED, LENT, OR DISPOSED OF DIRECTLY OR INDIRECTLY NOR USED FOR ANY PURPOSE OTHER THAN THAT FOR WHICH IT IS SPECIFICALLY FURNISHED. THE APPARATUS SHOWN IN THE DRAWING MAY BE COVERED BY PATENTS AND/OR MAY BE PROPRIETARY

uop

BASED ON

PIPING AND INSTRUMENT DIAGRAM
TYPICAL PUMP SEAL PLAN (4/4)
CONCENTRATION, DECOMPOSITION, AND
NEUTRALIZATION SECTION
UOP PHENOL PROCESS UNIT

Z1	AS BUILT	HSO	SWP	JSC	SWL	4/25/16
S4	ISSUED FOR CONSTRUCTION NO HOLDS	HSO	SWP	JSC	SWL	10/15/14
S3	ISSUED FOR CONSTRUCTION NO HOLDS	HSO	SWP	JSC	SWL	10/8/14
S2	ISSUED FOR CONSTRUCTION NO HOLDS	HSO	SWP	JSC	SWL	9/16/14
S1	ISSUED FOR CONSTRUCTION NO HOLDS	HSO	SWP	JSC	SWL	8/20/14
R2	ISSUED FOR CONSTRUCTION WITH HOLDS	HSO	SWP	JSC	SWL	4/4/14
R1	ISSUED FOR CONSTRUCTION WITH HOLDS	HSO	SWP	JSC	SWL	2/28/14
A2	APPROVED FOR DESIGN	HSO	SWP	JSC	SWL	2/7/14
REV.	DESCRIPTION	BY	CHK.	APPR.	PROJ. APPR.	DATE

CERTIFIED FOR CONSTRUCTION		DWG.	DSGN.	CHK.	APPR.
BY	DATE				
PROJ. NO.		DWG. NO.			REV.
PEN	120117				Z1
PPCL	14780-8120-25-23-0001L				

SCALE