

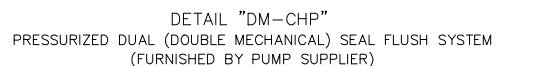



NOTE: THE INFORMATION IN THIS DOCUMENT IS CONFIDENTIAL AND THE PROPERTY OF UOP LLC AND MUST NOT BE DISCLOSED TO OTHERS OR REPRODUCED IN ANY MANNER OR USED FOR ANY PURPOSE WHATSOEVER WITHOUT ITS WRITTEN PERMISSION

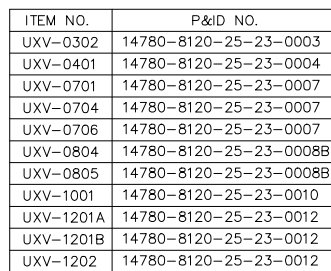

ITEM NO.	P&ID NO.
UXV-0301	14780-8120-25-23-0003
UXV-0501	14780-8120-25-23-0005
UXV-0502	14780-8120-25-23-0005
UXV-0601	14780-8120-25-23-0006
UXV-0702	14780-8120-25-23-0007
UXV-0703	14780-8120-25-23-0007
UXV-0705	14780-8120-25-23-0007
UXV-0707	14780-8120-25-23-0007
UXV-0801	14780-8120-25-23-0008
UXV-0802	14780-8120-25-23-0008
UXV-1204	14780-8120-25-23-0012
UXV-1205	14780-8120-25-23-0012
UXV-1206	14780-8120-25-23-0012A
UXV-1401	14780-8120-25-23-0014
UXV-1402	14780-8120-25-23-0014A
UXV-1403	14780-8120-25-23-0014A

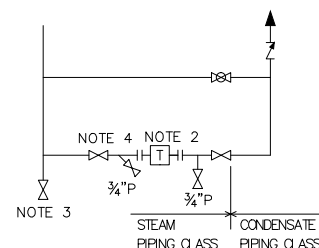


DETAIL "LCV-CD"

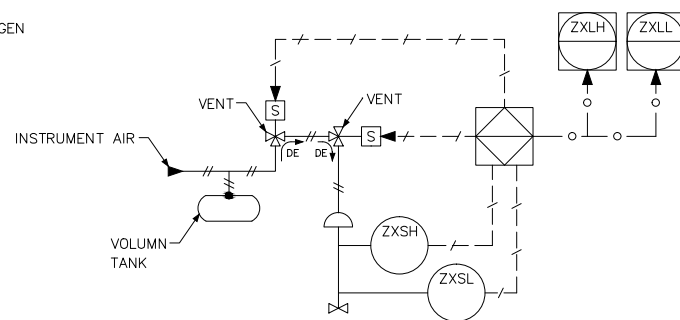

DETAIL "UT"



ITEM NO.	P&ID NO.
UXV-0803	14780-8120-25-23-0008A
UXV-1203	14780-8120-25-23-0012

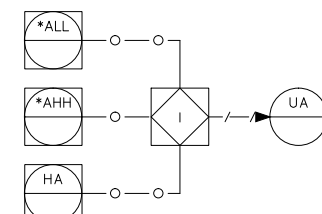

DETAIL "XX"
SHUTDOWN FUNCTION COMMON ALARM DETAIL

TAG NO.	P&ID NO.	ANN NO.
HXA-23-0101	14780-8120-25-23-0001	UA-23-2301
FXALL-23-0401	14780-8120-25-23-0004	
LXAHH-23-0401	14780-8120-25-23-0004	
TXAHH-23-0404	14780-8120-25-23-0004	
TXAHH-23-0501	14780-8120-25-23-0005	
TXAHH-23-0502	14780-8120-25-23-0005	
TXAHH-23-0701	14780-8120-25-23-0007	
TXAHH-23-0702	14780-8120-25-23-0007	
TXAHH-23-0805	14780-8120-25-23-0008	
LXAHH-23-0802	14780-8120-25-23-0008	UA-23-2302
TXAHH-23-0901	14780-8120-25-23-0009	
PXAHH-23-0801	14780-8120-25-23-0008	
HXA-23-0104	14780-8120-25-23-0001	
PXALL-23-1201	14780-8120-25-23-0012A	
FXALL-23-1204	14780-8120-25-23-0012	
TXAHH-23-1301	14780-8120-25-23-0013	
TXALL-23-1301	14780-8120-25-23-0013	
LXAHH-23-1302	14780-8120-25-23-0013	
TXAHH-23-1402	14780-8120-25-23-0014	UA-23-2303
TXAH-23-1603	14780-8120-25-23-0016	
PDXALL-23-1701	14780-8120-25-23-0017	
TDXAHH-23-1801	14780-8120-25-23-0018	
TDXAHH-23-1802	14780-8120-25-23-0018	
TDXAHH-23-1803	14780-8120-25-23-0018	
TDXAHH-23-1804	14780-8120-25-23-0018	
FXALL-23-1805	14780-8120-25-23-0018	
Vacuum Pump Shutdown	14780-8120-25-23-0010	

CROSS-TIE DESIGNATION

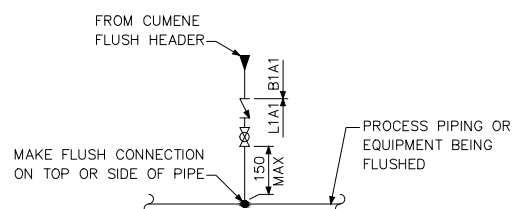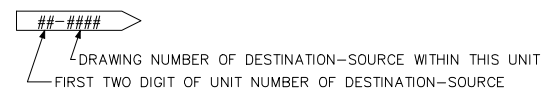

DETAIL "L"

NITROGEN FROM CHP NITROGEN
HEADER AT OXIDATION SECTION

TO CHP NITROGEN HEADER USERS
AS REQUIRED

CHP NITROGEN HEADER

ALL UTILITY NITROGEN CONNECTION UPSTREAM OF UV-1205 (DECOMPOSER FEED), AND ONLY THOSE UTILITY NITROGEN CONNECTIONS THAT ARE UPSTREAM OF UV-1205, ARE TO BE FROM CHP NITROGEN HEADER.

ALL UTILITY NITROGEN CONNECTIONS DOWNSTREAM OF
UV-1205 (DECOMPOSER FEED) TO BE FROM REGULAR NITROGEN HEADER.

Z1	AS BUILT	HSD	SWP	JSC	SWL	4/25/16
FS4-1	ISSUED FOR CONSTRUCTION NO HOLDS	HSD	SWP	JSC	SWL	10/31/17
S4	ISSUED FOR CONSTRUCTION NO HOLDS	HSD	SWP	JSC	SWL	10/15/17
S3	ISSUED FOR CONSTRUCTION NO HOLDS	HSD	SWP	JSC	SWL	10/6/17
S2	ISSUED FOR CONSTRUCTION NO HOLDS	HSD	SWP	JSC	SWL	9/16/17
S1	ISSUED FOR CONSTRUCTION NO HOLDS	HSD	SWP	JSC	SWL	8/20/17
R2	ISSUED FOR CONSTRUCTION WITH HOLDS	HSD	SWP	JSC	SWL	4/4/17
R1	ISSUED FOR CONSTRUCTION WITH HOLDS	HSD	SWP	JSC	SWL	2/28/17
REV.	DESCRIPTION	BY	CHK.	APPR.	PROJ. APPR.	DATE

GENERAL NOTES

1. ALL PRESSURE RELIEF VALVES AND INSTRUMENTS ARE PREFIXED WITH AAA-23-. AS AN EXAMPLE FOR INSTRUMENT FIC-23-0202 ONLY FIC-0202 WILL BE SHOWN IN THE INSTRUMENT SYMBOL.
2. ALL DIMENSION ARE IN MILLIMETERS UNLESS SPECIFICALLY NOTE OTHERWISE.

NOTES

1. ALL LOW POINT DRAIN IN CHP SERVICE MUST CONNECT TO THE CHP CLOSED DRAIN HEADER.
2. HORIZONTAL RUNS SHALL BE HELD TO A MINIMUM AND SLOPED WHERE POSSIBLE.
3. MIN. 2" FOR THE MAIN LINE WHICH IS 2" AND LARGER, OTHERWISE USE THE SAME SIZE AS MAIN LINE.
4. IF THE TRAP HAS INTEGRAL STRAIN "Y" TYPE STRAINER CAN BE DELETED.



THIS DRAWING IS CONFIDENTIAL PROPERTY OF
PTT PHENOL COMPANY LIMITED

AND IS LENT WITHOUT CONSIDERATION OTHER THAN THE BORROWER'S AGREEMENT THAT IT SHALL NOT BE RE-PRODUCED, COPIED, LENT, OR DISPOSED OF DIRECTLY OR INDIRECTLY NOR USED FOR ANY PURPOSE OTHER THAN THAT FOR WHICH IT IS SPECIFICALLY FURNISHED. THE APPARATUS SHOWN IN THE DRAWING MAY BE COVERED BY PATENTS AND/OR MAY BE PROPRIETARY.



BASED ON 963766-120-01-A1

PIPING AND INSTRUMENT DIAGRAM
UNIT SPECIFIC DETAILS AND NOTES CONCENTRATION
DECOMPOSITION, AND NEUTRALIZATION SECTION
UOP PHENOL PROCESS UNIT

15	CERTIFIED FOR CONSTRUCTION		DWG.	DSGN.	CHK.	APPR.
14						

4	BY _____	BY				
4	DATE _____	DATE				

4	PROJ. NO.	DWG. NO.	REV.
4			

4	PEN	120117		Z1

SCALE