


ITEM No. : X-2302A/B
SERVICE : PREFLASH COLUMN FEED FILTERS
SIZE DIAMETER X LENGTH(T/T) : 368.4 mm x 2662 mm
DESIGN PRESS. AND TEMP. : FV, 11.5 kg/cm2g / 82.1°C , 120°C
OPERATING PRESS. AND TEMP. : 8 kg/cm2g / 82°C
INSULATION : H(40)
(LOCATE AT PREFLASH COLUMN)

GENERAL NOTES

- 1.FOR ABBREVIATIONS, SYMBOLS & GENERAL NOTES, REFER TO LEGEND SHEETS 14780-8120-25-00-0001A THRU 0004
2. ALL INSTRUMENTS AND PIPING SPECIALTY ITEMS ON THIS DRAWING WILL BE PREFIXED BY UNIT NO. 2300.
3. FOR UNIT SPECIFIC DETAILS AND NOTES, REFER TO DWG. 14780-8120-25-23-0001.
4. FOR DETAILS OF CONTROL VALVE VENT & DRAIN, REFER TO DWG. 14780-8120-25-23-0001A.
5. FOR DETAILS OF LEVEL INSTRUMENT VENT & DRAIN, REFER TO DWG. 14780-8120-25-23-0001B.
6. FOR DETAILS OF PUMP VENT & DRAIN, REFER TO DWG. 14780-8120-25-23-0001C.
7. FOR DETAILS OF SAMPLING SYSTEM, REFER TO DWG. 14780-8120-25-23-0001D THRU 0001E.
8. FOR DETAILS OF PUMP AUXILIARY LINE, MOTOR CONTROL AND SEAL PLAN, REFER TO DWG. 14780-8120-25-23-0001F THRU 0001K.

NOTES

1. (*) : INSULATION FOR PIPING CONTAINING MORE THAN 5 WT% CHP MUST MEET SPECIAL REQUIREMENTS. SEE PROJECT SPECIFICATION 907 FOR DETAILS.
2. FOR DETAIL OF VALVE SEE DWG NO. 14780-8120-25-23-0001. DETAIL "UP"
3. FOR DETAIL OF VALVE SEE DWG NO. 14780-8120-25-23-0001. DETAIL "U"
4. THE SET PRESSURE OF ELEVATED PSV HAS BEEN ADJUSTED FOR LIQUID STATIC HEAD.

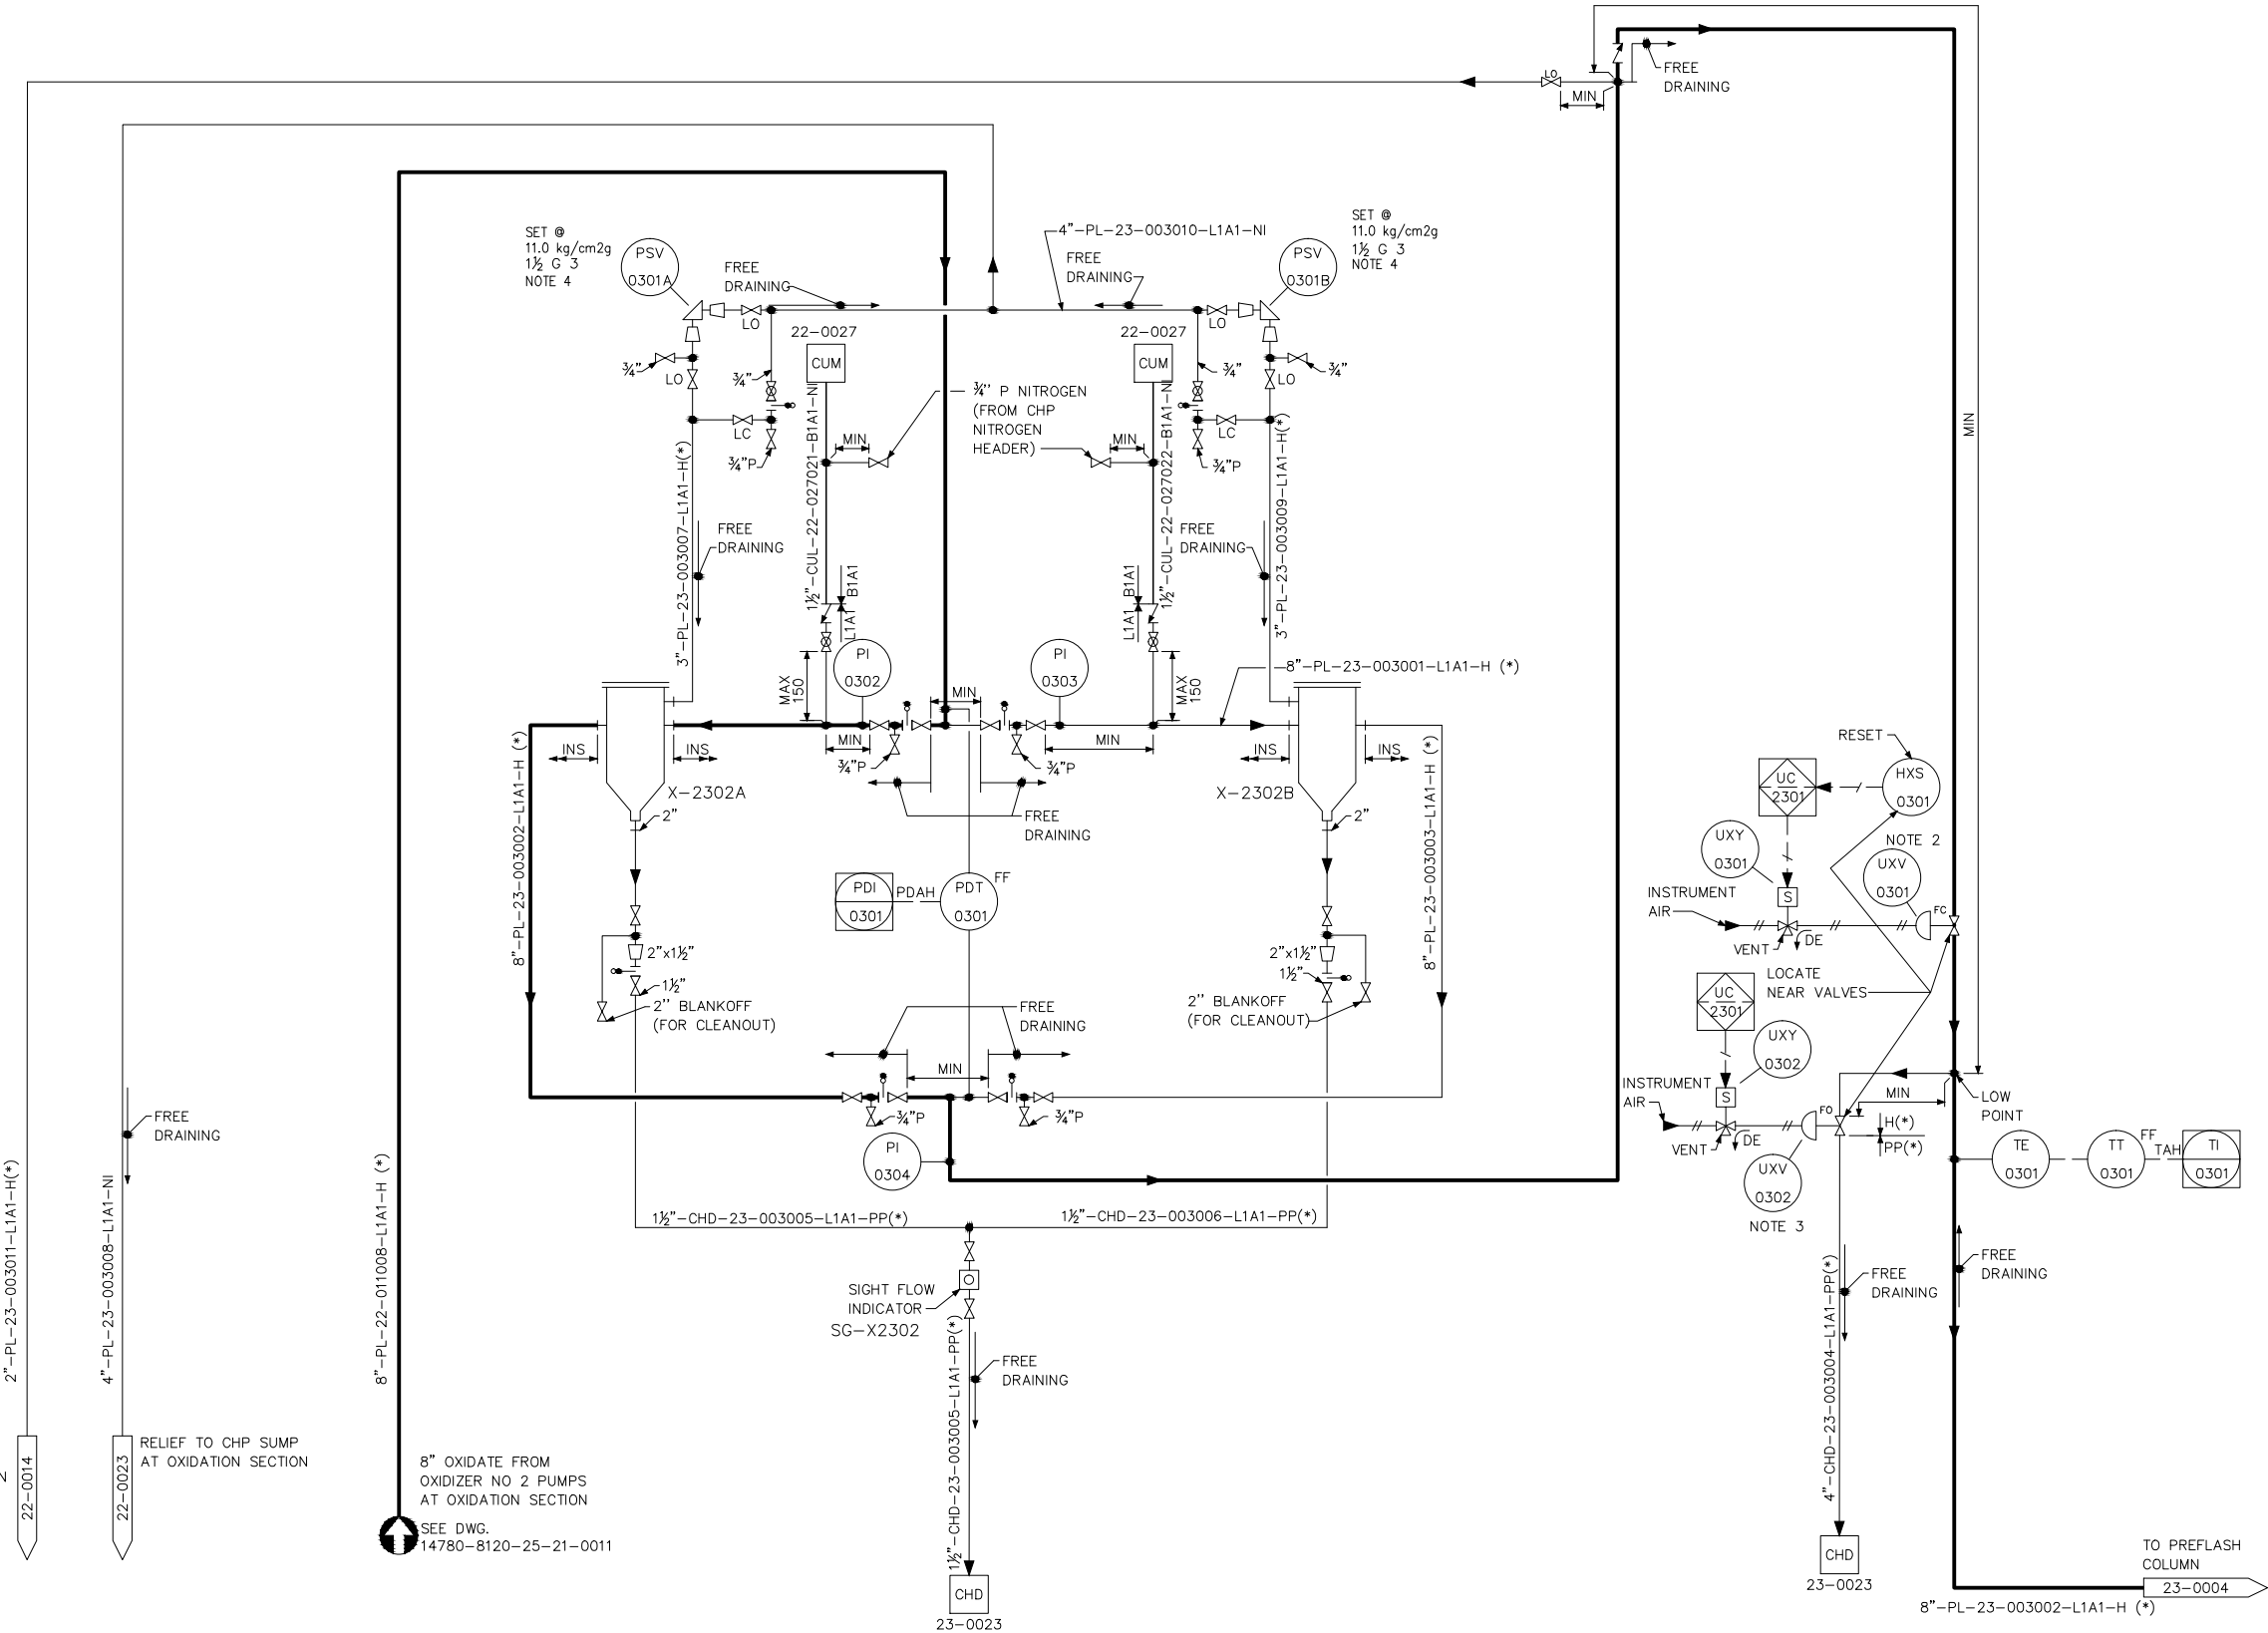

THIS DRAWING IS CONFIDENTIAL PROPERTY OF
PTT PHENOL COMPANY LIMITED
AND IS LENT WITHOUT CONSIDERATION OTHER THAN THE BORROWER'S AGREEMENT
THAT IT SHALL NOT BE RE-PRODUCED, COPIED, LENT, OR DISPOSED OF DIRECTLY OR
INDIRECTLY NOR USED FOR ANY PURPOSE OTHER THAN THAT FOR WHICH IT IS
SPECIFICALLY FURNISHED. THE APPARATUS SHOWN IN THE DRAWING MAY BE COVERED
BY PATENTS AND/OR MAY BE PROPRIETARY

uop BASED ON 963766-120-03-A1

PIPING AND INSTRUMENT DIAGRAM
PREFLASH COLUMN FEED FILTERS CONCENTRATION,
DECOMPOSITION, AND NEUTRALIZATION SECTION
UOP PHENOL PROCESS UNIT

REV.	DESCRIPTION	BY	CHK.	APPR.	DATE
Z1	AS BUILT	HSO	SWP	JSC	SWL 4/25/16
FS4-2	ISSUED FOR CONSTRUCTION NO HOLDS	HSO	SWP	JSC	SWL 7/23/15
FS4-1	ISSUED FOR CONSTRUCTION NO HOLDS	HSO	SWP	JSC	SWL 7/21/15
S4	ISSUED FOR CONSTRUCTION NO HOLDS	HSO	SWP	JSC	SWL 10/15/14
S3	ISSUED FOR CONSTRUCTION NO HOLDS	HSO	SWP	JSC	SWL 10/8/14
S2	ISSUED FOR CONSTRUCTION NO HOLDS	HSO	SWP	JSC	SWL 9/16/14
S1	ISSUED FOR CONSTRUCTION NO HOLDS	HSO	SWP	JSC	SWL 8/20/14
R2	ISSUED FOR CONSTRUCTION WITH HOLDS	HSO	SWP	JSC	SWL 4/4/14

BY	DATE	DWG.	DSGN.	CHK.	APPR.
BY	DATE				
PROJ. NO.	DWG. NO.	REV.			
PEN	120117				Z1
PPCL	14780-8120-25-23-0003				

SCALE