

NOTE: THE INFORMATION IN THIS DOCUMENT IS CONFIDENTIAL AND THE PROPERTY OF UOP LLC AND MUST NOT BE DISCLOSED TO OTHERS OR REPRODUCED IN ANY MANNER OR USED FOR ANY PURPOSE WHATSOEVER WITHOUT ITS WRITTEN PERMISSION.

THESE P AND I DIAGRAM IS DIAGRAMATIC ONLY. DESIGN OF PIPE LINES MUST BE INVESTIGATED FOR VENTING OF GAS AND VAPOR POCKETS IN PIPING AND EQUIPMENT. LOW POINTS IN PIPING, PUMPS AND EQUIPMENT FOR FREEZING AND DRAINING, AND ACCESSIBILITY OF ALL VALVES, FLANGES, INSTRUMENTS INCLUDING THERMOCOUPLES, ETC.

14780-8120-25-23-0007

B

C

D

E


F

G

H

J

ITEM No. : E-2304
SERVICE : FLASH COLUMN VAPORIZER
DESIGN DUTY : 4.147 x 1.05 MMKcal/hr
SIZE(DIA/TUBE LENGTH / H.T.SURFACE) : 1750 mm / 2438 mm / 479.1 m2
SHELL DESIGN PRESS. AND TEMP. : FV, 10.5 kg/cm2g / 195°C, 195°C
TUBE DESIGN PRESS. AND TEMP. : FV, 4 kg/cm2g / 195°C, 250°C
INSULATION (S/T) : H(80) / H(80)

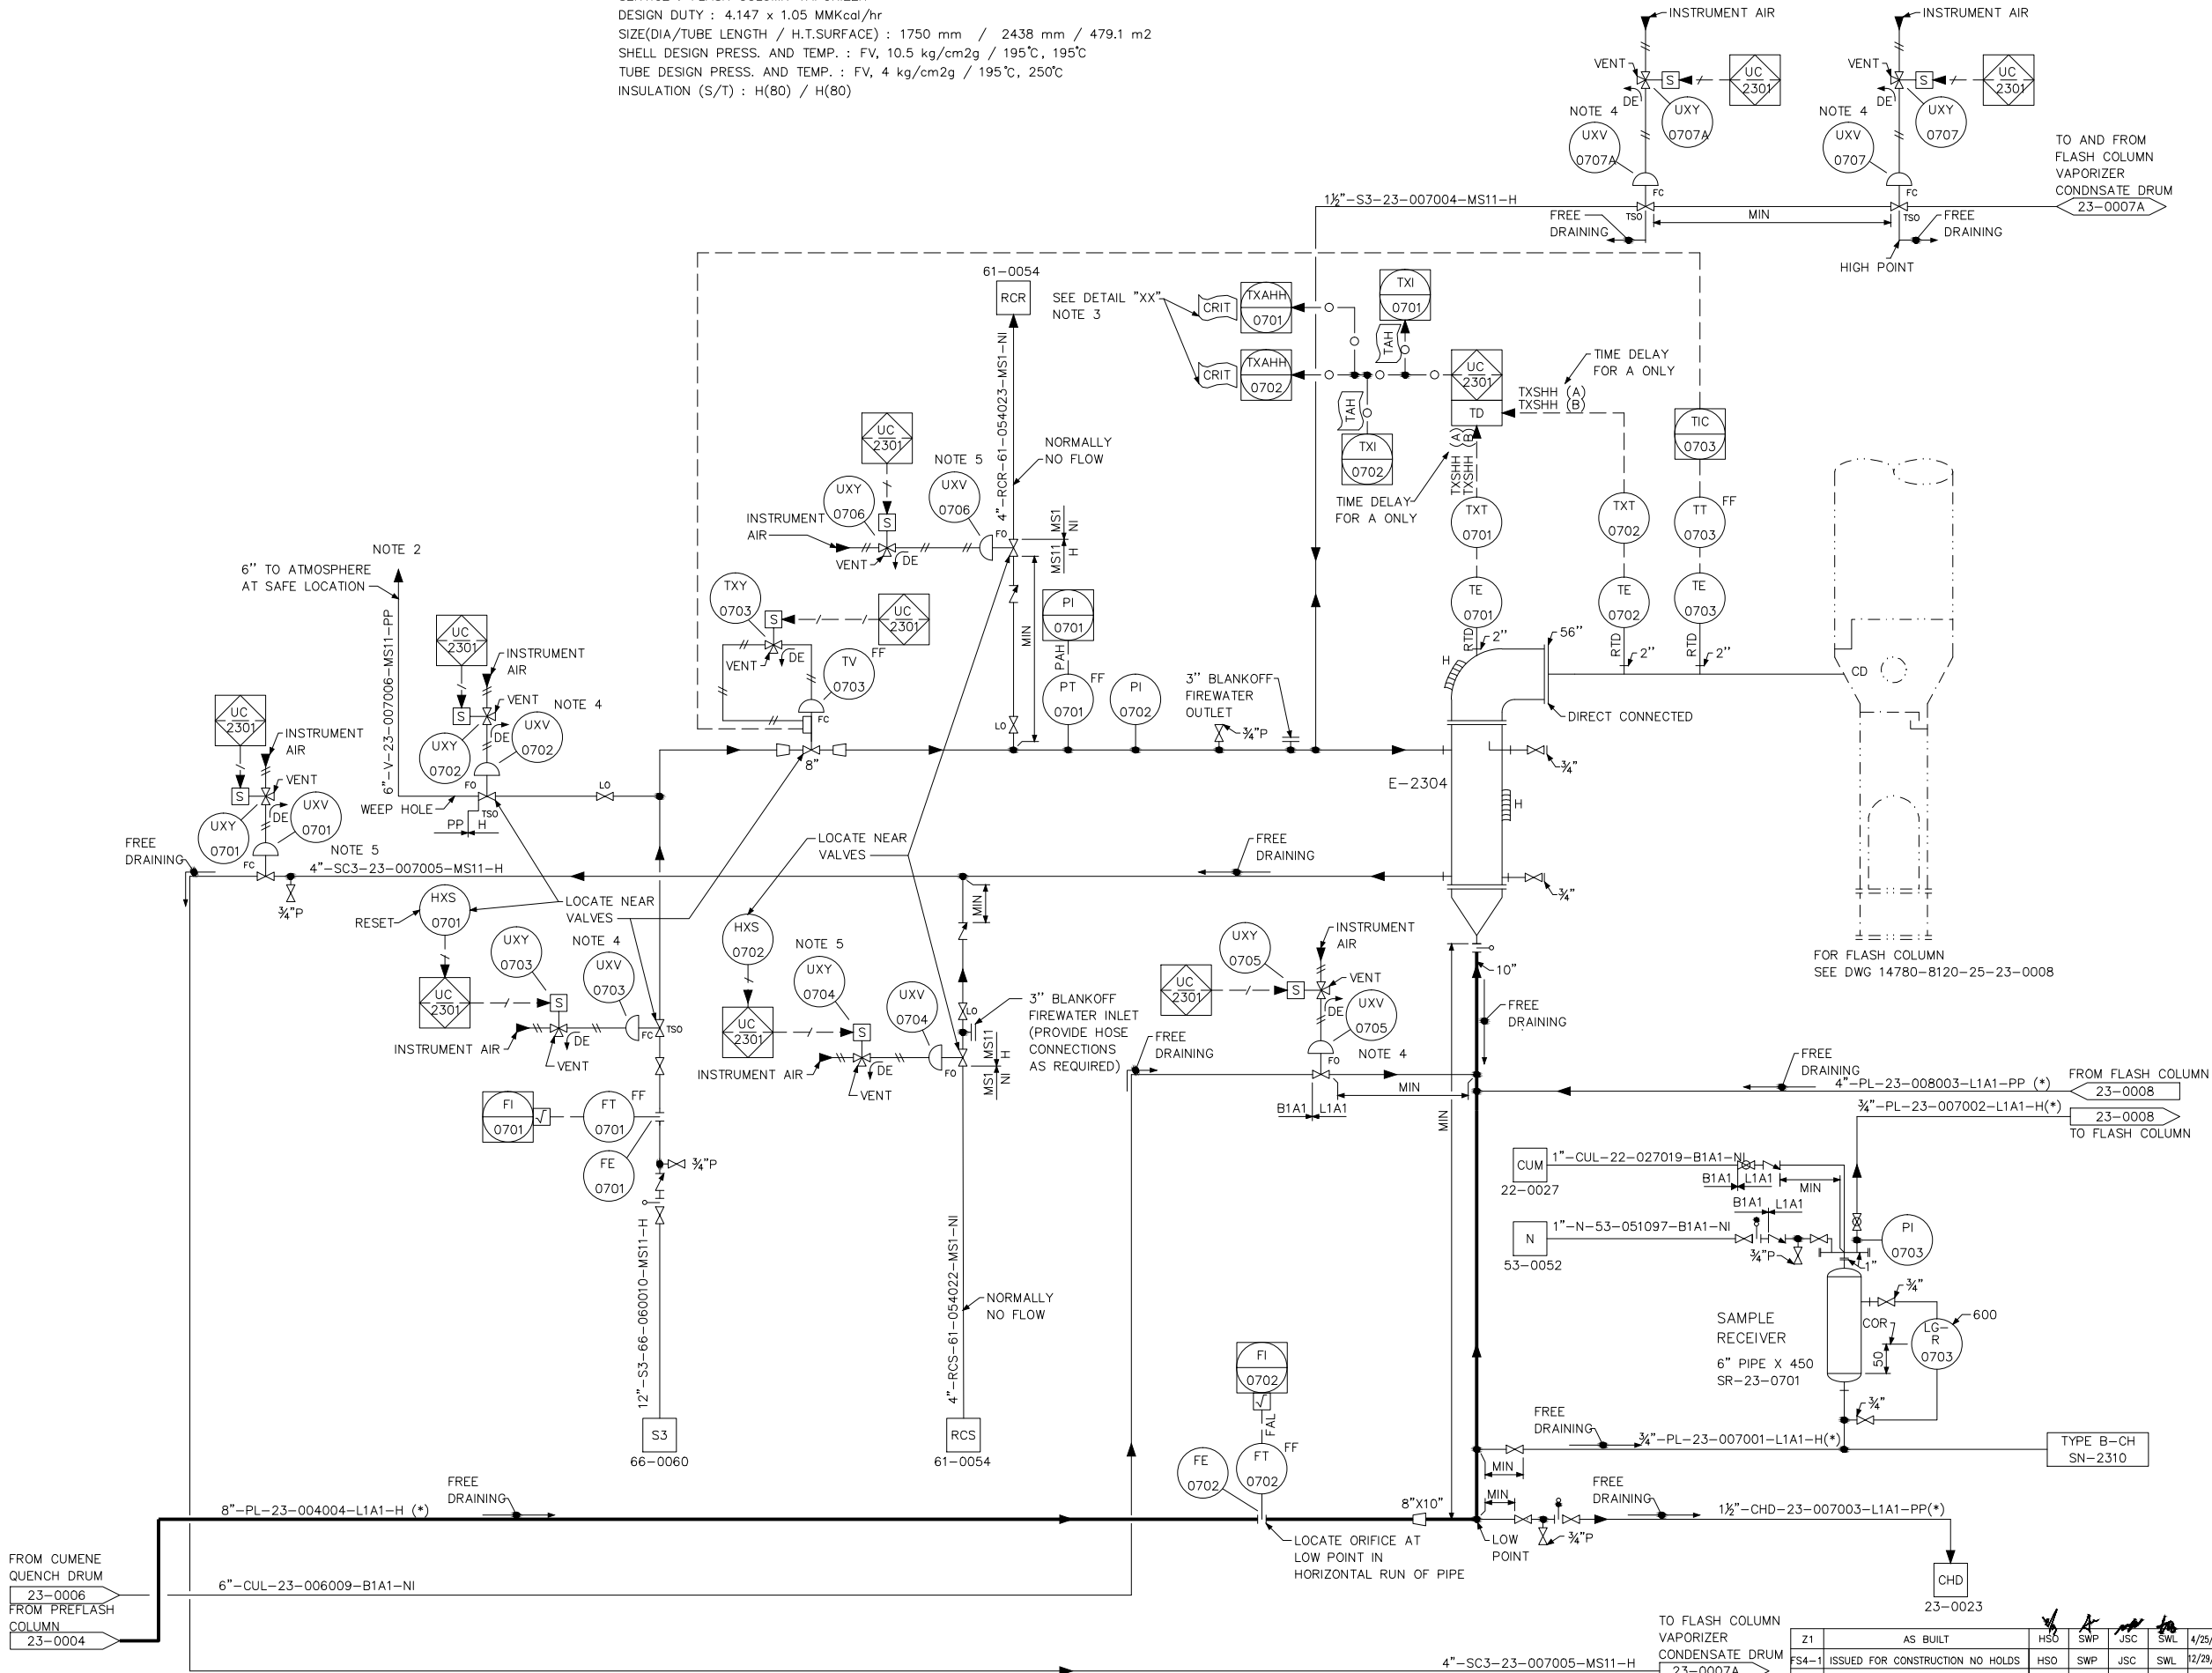

GENERAL NOTES

1. FOR ABBREVIATIONS, SYMBOLS & GENERAL NOTES, REFER TO LEGEND SHEETS 14780-8120-25-00-0001A THRU 0004
2. ALL INSTRUMENTS AND PIPING SPECIALTY ITEMS ON THIS DRAWING WILL BE PREFIXED BY UNIT NO. 2300.
3. FOR UNIT SPECIFIC DETAILS AND NOTES, REFER TO DWG. 14780-8120-25-23-0001.
4. FOR DETAILS OF CONTROL VALVE VENT & DRAIN, REFER TO DWG. 14780-8120-25-23-0001A.
5. FOR DETAILS OF LEVEL INSTRUMENT VENT & DRAIN, REFER TO DWG. 14780-8120-25-23-0001B.
6. FOR DETAILS OF PUMP VENT & DRAIN, REFER TO DWG. 14780-8120-25-23-0001C.
7. FOR DETAILS OF SAMPLING SYSTEM, REFER TO DWG. 14780-8120-25-23-0001D THRU 0001E.
8. FOR DETAILS OF PUMP AUXILIARY LINE, MOTOR CONTROL AND SEAL PLAN, REFER TO DWG. 14780-8120-25-23-0001F THRU 0001K.

NOTES

1. (*) : INSULATION FOR PIPING CONTAINING MORE THAN 5 WT% CHP MUST MEET SPECIAL REQUIREMENTS. SEE PROJECT SPECIFICATION 907 FOR DETAILS.
2. BIRD SCREEN TO BE INSTALLED AT THE END OF VENT LINE.
3. FOR DETAIL "XX" SEE DWG NO. 14780-8120-25-23-0001.
4. FOR DETAIL OF VALVE SEE DWG NO. 14780-8120-25-23-0001. DETAIL "UP"
5. FOR DETAIL OF VALVE SEE DWG NO. 14780-8120-25-23-0001. DETAIL "U"



THIS DRAWING IS CONFIDENTIAL PROPERTY OF PTT PHENOL COMPANY LIMITED
AND IS LENT WITHOUT CONSIDERATION OTHER THAN THE BORROWER'S AGREEMENT THAT IT SHALL NOT BE RE-PRODUCED, COPIED, LENT, OR DISPOSED OF DIRECTLY OR INDIRECTLY NOR USED FOR ANY PURPOSE OTHER THAN THAT FOR WHICH IT IS SPECIFICALLY FURNISHED. THE APPARATUS SHOWN IN THE DRAWING MAY BE COVERED BY PATENTS AND/OR MAY BE PROPRIETARY

uop BASED ON 963766-120-07-A1

PIPING AND INSTRUMENT DIAGRAM
FLASH COLUMN VAPORIZER CONCENTRATION,
DECOMPOSITION, AND NEUTRALIZATION SECTION
UOP PHENOL PROCESS UNIT

CERTIFIED FOR CONSTRUCTION		DWG.	DSGN.	CHK.	APPR.
BY	DATE				
PROJ. NO.	DWG. NO.	REV.			
PEN	120117	Z1			
PPCL	14780-8120-25-23-0007				

Z1	AS BUILT	HSO	SWP	JSC	SWL	4/25/16
S4-1	ISSUED FOR CONSTRUCTION NO HOLDS	HSO	SWP	JSC	SWL	12/29/14
S4	ISSUED FOR CONSTRUCTION NO HOLDS	HSO	SWP	JSC	SWL	10/15/14
S3	ISSUED FOR CONSTRUCTION NO HOLDS	HSO	SWP	JSC	SWL	10/8/14
S2	ISSUED FOR CONSTRUCTION NO HOLDS	HSO	SWP	JSC	SWL	9/16/14
S1	ISSUED FOR CONSTRUCTION NO HOLDS	HSO	SWP	JSC	SWL	8/20/14
R2	ISSUED FOR CONSTRUCTION WITH HOLDS	HSO	SWP	JSC	SWL	4/4/14
R1	ISSUED FOR CONSTRUCTION WITH HOLDS	HSO	SWP	JSC	SWL	2/28/14
REV.	DESCRIPTION	BY	CHK.	APPR.	PRO. APPR.	DATE

SCALE