



NOTE: THE INFORMATION IN THIS DOCUMENT IS CONFIDENTIAL AND THE PROPERTY OF UOP LLC AND MUST NOT BE DISCLOSED TO OTHERS OR REPRODUCED IN ANY MANNER OR USED FOR ANY PURPOSE WHATSOEVER WITHOUT ITS WRITTEN PERMISSION.

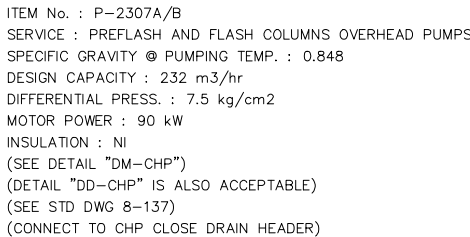

1. FOR ABBREVIATIONS, SYMBOLS & GENERAL NOTES,  
REFER TO LEGEND SHEETS 14780-8120-25-00-0001A  
THRU 0004
2. ALL INSTRUMENTS AND PIPING SPECIALTY ITEMS ON  
THIS DRAWING WILL BE PREFIXED BY UNIT NO. 2300.
3. FOR UNIT SPECIFIC DETAILS AND NOTES,  
REFER TO DWG. 14780-8120-25-23-0001.
4. FOR DETAILS OF CONTROL VALVE WELL & DRAIN,  
REFER TO DWG. 14780-8120-25-23-0001A.
5. FOR DETAILS OF LEVEL INSTRUMENT WELL & DRAIN,  
REFER TO DWG. 14780-8120-25-23-0001B.
6. FOR DETAILS OF PUMP WELL & DRAIN,  
REFER TO DWG. 14780-8120-25-23-0001C.
7. FOR DETAILS OF SAMPLING SYSTEM,  
REFER TO DWG. 14780-8120-25-23-0001D  
THRU 0001E.
8. FOR DETAILS OF PUMP AUXILIARY LINE, MOTOR  
CONTROL AND SEAL PLAN, REFER TO  
DWG. 14780-8120-25-23-0001F THRU 0001K.

1. FOR DETAIL OF VALVE SEE DWG NO. 14780-8120-25-23-0001. DETAIL "U"
2. FOR DETAIL OF MOTOR CONTROL SEE DWG NO. 14780-8120-25-23-0001F "TYPE B"

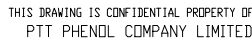

AND IS LENT WITHOUT CONSIDERATION OTHER THAN THE BORROWER'S AGREEMENT THAT IT SHALL NOT BE RE-PRODUCED, COPIED, LENT, OR DISPOSED OF DIRECTLY OR INDIRECTLY NOR USED FOR ANY PURPOSE OTHER THAN THAT FOR WHICH IT IS SPECIFICALLY FURNISHED. THE APPARATUS SHOWN IN THE DRAWING MAY BE COVERED BY PATENTS AND/OR MAY BE PROPRIETARY.

DRAWING IS CONFIDENTIAL PROPERTY OF  
ST PHENOL COMPANY LIMITED

AND IS LENT WITHOUT CONSIDERATION OTHER THAN THE BORROWER'S AGREEMENT THAT IT SHALL NOT BE RE-PRODUCED, COPIED, LENT, OR DISPOSED OF DIRECTLY OR INDIRECTLY NOR USED FOR ANY PURPOSE OTHER THAN THAT FOR WHICH IT IS SPECIFICALLY FURNISHED. THE APPARATUS SHOWN IN THE DRAWING MAY BE COVERED BY PATENTS AND/OR MAY BE PROPRIETARY.

DRAWING IS CONFIDENTIAL PROPERTY OF  
ST PHENOL COMPANY LIMITED

AND IS LENT WITHOUT CONSIDERATION OTHER THAN THE BORROWER'S AGREEMENT THAT IT SHALL NOT BE RE-PRODUCED, COPIED, LENT, OR DISPOSED OF DIRECTLY OR INDIRECTLY NOR USED FOR ANY PURPOSE OTHER THAN THAT FOR WHICH IT IS SPECIFICALLY FURNISHED. THE APPARATUS SHOWN IN THE DRAWING MAY BE COVERED BY PATENTS AND/OR MAY BE PROPRIETARY.

| Z1    | AS BUILT                         | HSD | SWP  | JSC   | SWL         | 4/25/'16  | NEUTRALIZATION SECTION UOP PHENOL PROCESS UNIT |                                    |                                    |          |       |      |       |
|-------|----------------------------------|-----|------|-------|-------------|-----------|------------------------------------------------|------------------------------------|------------------------------------|----------|-------|------|-------|
| F54-3 | ISSUED FOR CONSTRUCTION NO HOLDS | HSD | SWP  | JSC   | SWL         | 1/8/'16   | <div>CERTIFIED FOR CONSTRUCTION</div>          | <div>BY _____<br/>DATE _____</div> | <div>BY _____<br/>DATE _____</div> | DWG.     | DSGN. | CHK. | APPR. |
| F54-2 | ISSUED FOR CONSTRUCTION NO HOLDS | HSD | SWP  | JSC   | SWL         | 8/29/'15  |                                                |                                    |                                    |          |       |      |       |
| F54-1 | ISSUED FOR CONSTRUCTION NO HOLDS | HSD | SWP  | JSC   | SWL         | 12/29/'14 |                                                |                                    |                                    |          |       |      |       |
| S4    | ISSUED FOR CONSTRUCTION NO HOLDS | HSD | SWP  | JSC   | SWL         | 10/15/'14 |                                                |                                    |                                    |          |       |      |       |
| S3    | ISSUED FOR CONSTRUCTION NO HOLDS | HSD | SWP  | JSC   | SWL         | 10/8/'14  |                                                | PROJ. NO.                          |                                    | DWG. NO. |       |      | REV.  |
| S2    | ISSUED FOR CONSTRUCTION NO HOLDS | HSD | SWP  | JSC   | SWL         | 9/16/'14  | PEN                                            | 120117                             |                                    |          |       |      |       |
| S1    | ISSUED FOR CONSTRUCTION NO HOLDS | HSD | SWP  | JSC   | SWL         | 8/20/'14  |                                                |                                    |                                    |          |       |      |       |
| REV.  | DESCRIPTION                      | BY  | CHK. | APPR. | PROJ. APPR. | DATE      | PPCL                                           | 14780-8120-25-23-0008B             |                                    |          |       |      | Z1    |

SCALE