

THESE P AND I DIAGRAM IS DIAGRAMATIC ONLY. DESIGN OF PIPE LINES MUST BE INVESTIGATED FOR VENTING OF GAS AND VAPOR POCKETS IN PIPING AND EQUIPMENT. LOW POINTS IN PIPING, PUMPS AND EQUIPMENT FOR FREEZING AND DRAINING, AND ACCESSIBILITY OF ALL VALVES, FLANGES, INSTRUMENTS INCLUDING THERMOCOUPLES, ETC.

NOTE: THE INFORMATION IN THIS DOCUMENT IS CONFIDENTIAL AND THE PROPERTY OF UOP LLC AND MUST NOT BE DISCLOSED TO OTHERS OR REPRODUCED IN ANY MANNER OR USED FOR ANY PURPOSE WHATSOEVER WITHOUT ITS WRITTEN PERMISSION.

UO100-52-25-0218-08141

ITEM No. : E-2316
SERVICE : INTER CONDENSER
DESIGN DUTY : 0.85 MMKcal/hr
SIZE(DIA/TUBE LENGTH / H.T.SURFACE) : 790 mm / 3770 mm / 71.3 m2
SHELL DESIGN PRESS. AND TEMP. : FV, 4 kg/cm2g / 250°C
TUBE DESIGN PRESS. AND TEMP. : 11.5 kg/cm2g / 120°C
INSULATION (S/T) : P(40) / C(50)

ITEM No. : J-2301/J-2302A/B EJECTOR
TYPE : STEAM EJECTOR
SUCTION FLOW : 238.6 kg/hr
SUCTION PRESS./TEMP. : 10 mmHg / 5°C
DISCHARGE PRESS./TEMP. : 79.7 mmHg / 138°C
MATERIAL : SS316L

ITEM No. : P-2316A/B VACUUM PUMP
TYPE : LIQUID RING (XL130)
SUCTION FLOW : 238.6 kg/hr
SUCTION PRESS./TEMP. : 79.7 mmHg / 8.3°C
DISCHARGE PRESS./TEMP. : 804 mmHg / 18°C
MOTOR : 55kW/4POLE/380V/50HZ/Ex nA
MATERIAL : SS316



ITEM No. : D-2316 SEPARATOR
TYPE : VERTICAL
CODE : ASME SEC.VIII DIV.1
SIZE : 406 x 1200mm
DESIGN PRESSURE : 3.5 kg/cm2G
DESIGN TEMPERATURE : 120°C
CAPACITY : 0.155 m3
MATERIAL : SS316L

ITEM No. : E-2317A/B SEALANT LIQUID COOLER
TYPE : SHELL&TUBE / AEM
CODE : ASME SEC.VIII DIV.1
SIZE : 264 x 5599 mm
HEAT EXCHANGED : 26505 kcal/hr
DESIGN PRES. SHELL/TUBE : 8.9/15 kg/cm2G
DESIGN TEMP. SHELL/TUBE : 120/120°C
MATERIAL : SS304L

ITEM No. : P-2317A/B SEALANT PUMP
TYPE : CENTRIFUGAL
CODE : ASME B73.1
CAPACITY : 3.3m3/hr
DISCHARGE PRESSURE : 0.85 kg/cm2G
DESIGN PRESSURE : 15kg/cm2G
MATERIAL : SS316

- GENERAL NOTES
- FOR ABBREVIATIONS, SYMBOLS & GENERAL NOTES, REFER TO LEGEND SHEETS 14780-8120-25-00-0001A THRU 0004
 - ALL INSTRUMENTS AND PIPING SPECIALTY ITEMS ON THIS DRAWING WILL BE PREFIXED BY UNIT NO. 2300.
 - FOR UNIT SPECIFIC DETAILS AND NOTES, REFER TO DWG. 14780-8120-25-23-0001.
 - FOR DETAILS OF CONTROL VALVE VENT & DRAIN, REFER TO DWG. 14780-8120-25-23-0001A.
 - FOR DETAILS OF LEVEL INSTRUMENT VENT & DRAIN, REFER TO DWG. 14780-8120-25-23-0001B.
 - FOR DETAILS OF PUMP VENT & DRAIN, REFER TO DWG. 14780-8120-25-23-0001C.
 - FOR DETAILS OF SAMPLING SYSTEM, REFER TO DWG. 14780-8120-25-23-0001D THRU 0001E.
 - FOR DETAILS OF PUMP AUXILIARY LINE, MOTOR CONTROL AND SEAL PLAN, REFER TO DWG. 14780-8120-25-23-0001F THRU 0001K.

- NOTES
- FOR DETAIL "XX" SEE DWG NO. 14780-8120-25-23-0001.
 - FOR DETAIL OF VALVE SEE DWG NO. 14780-8120-25-23-0001. DETAIL "U"
 - TAPPING POINT FOR OXYGEN ANALYZER SHALL BE CLOSED TO SEPARATOR TOP NOZZLE IN VACUUM SYSTEM.
 - OXYGEN ANALYZER HAS BEEN PROVIDED BY CONTRACTOR.
 - PSV-23-1006A/B HAS BEEN PROVIDED BY X-2301 VENDOR SUCTION AND DISCHARGE PIPELINE OF PSV-23-1006A/B HAS BEEN SUPPLIED BY CONTRACTOR.
 - FOR THE DETAIL OF SEAL, SEE DETAIL "S"
 - RESET HAND SWITCH (ONLY DCS S/W) FOR P-2316A/B, P-2317A/B : HXS-23-2316

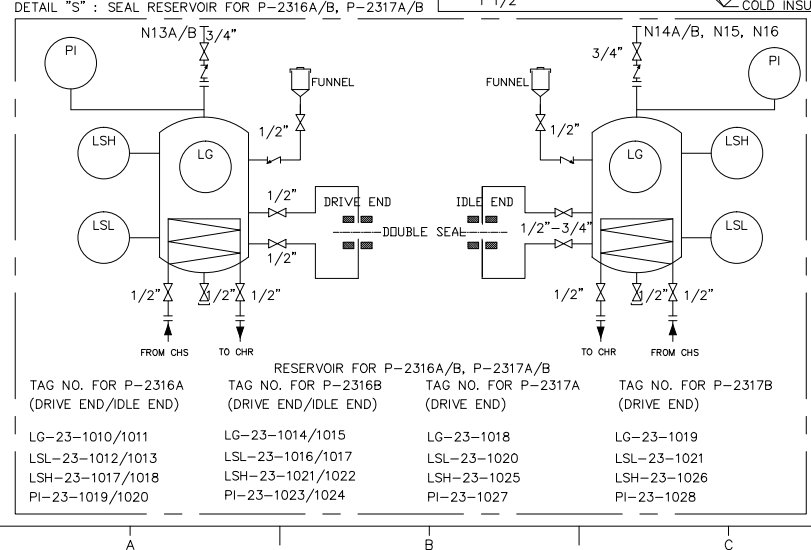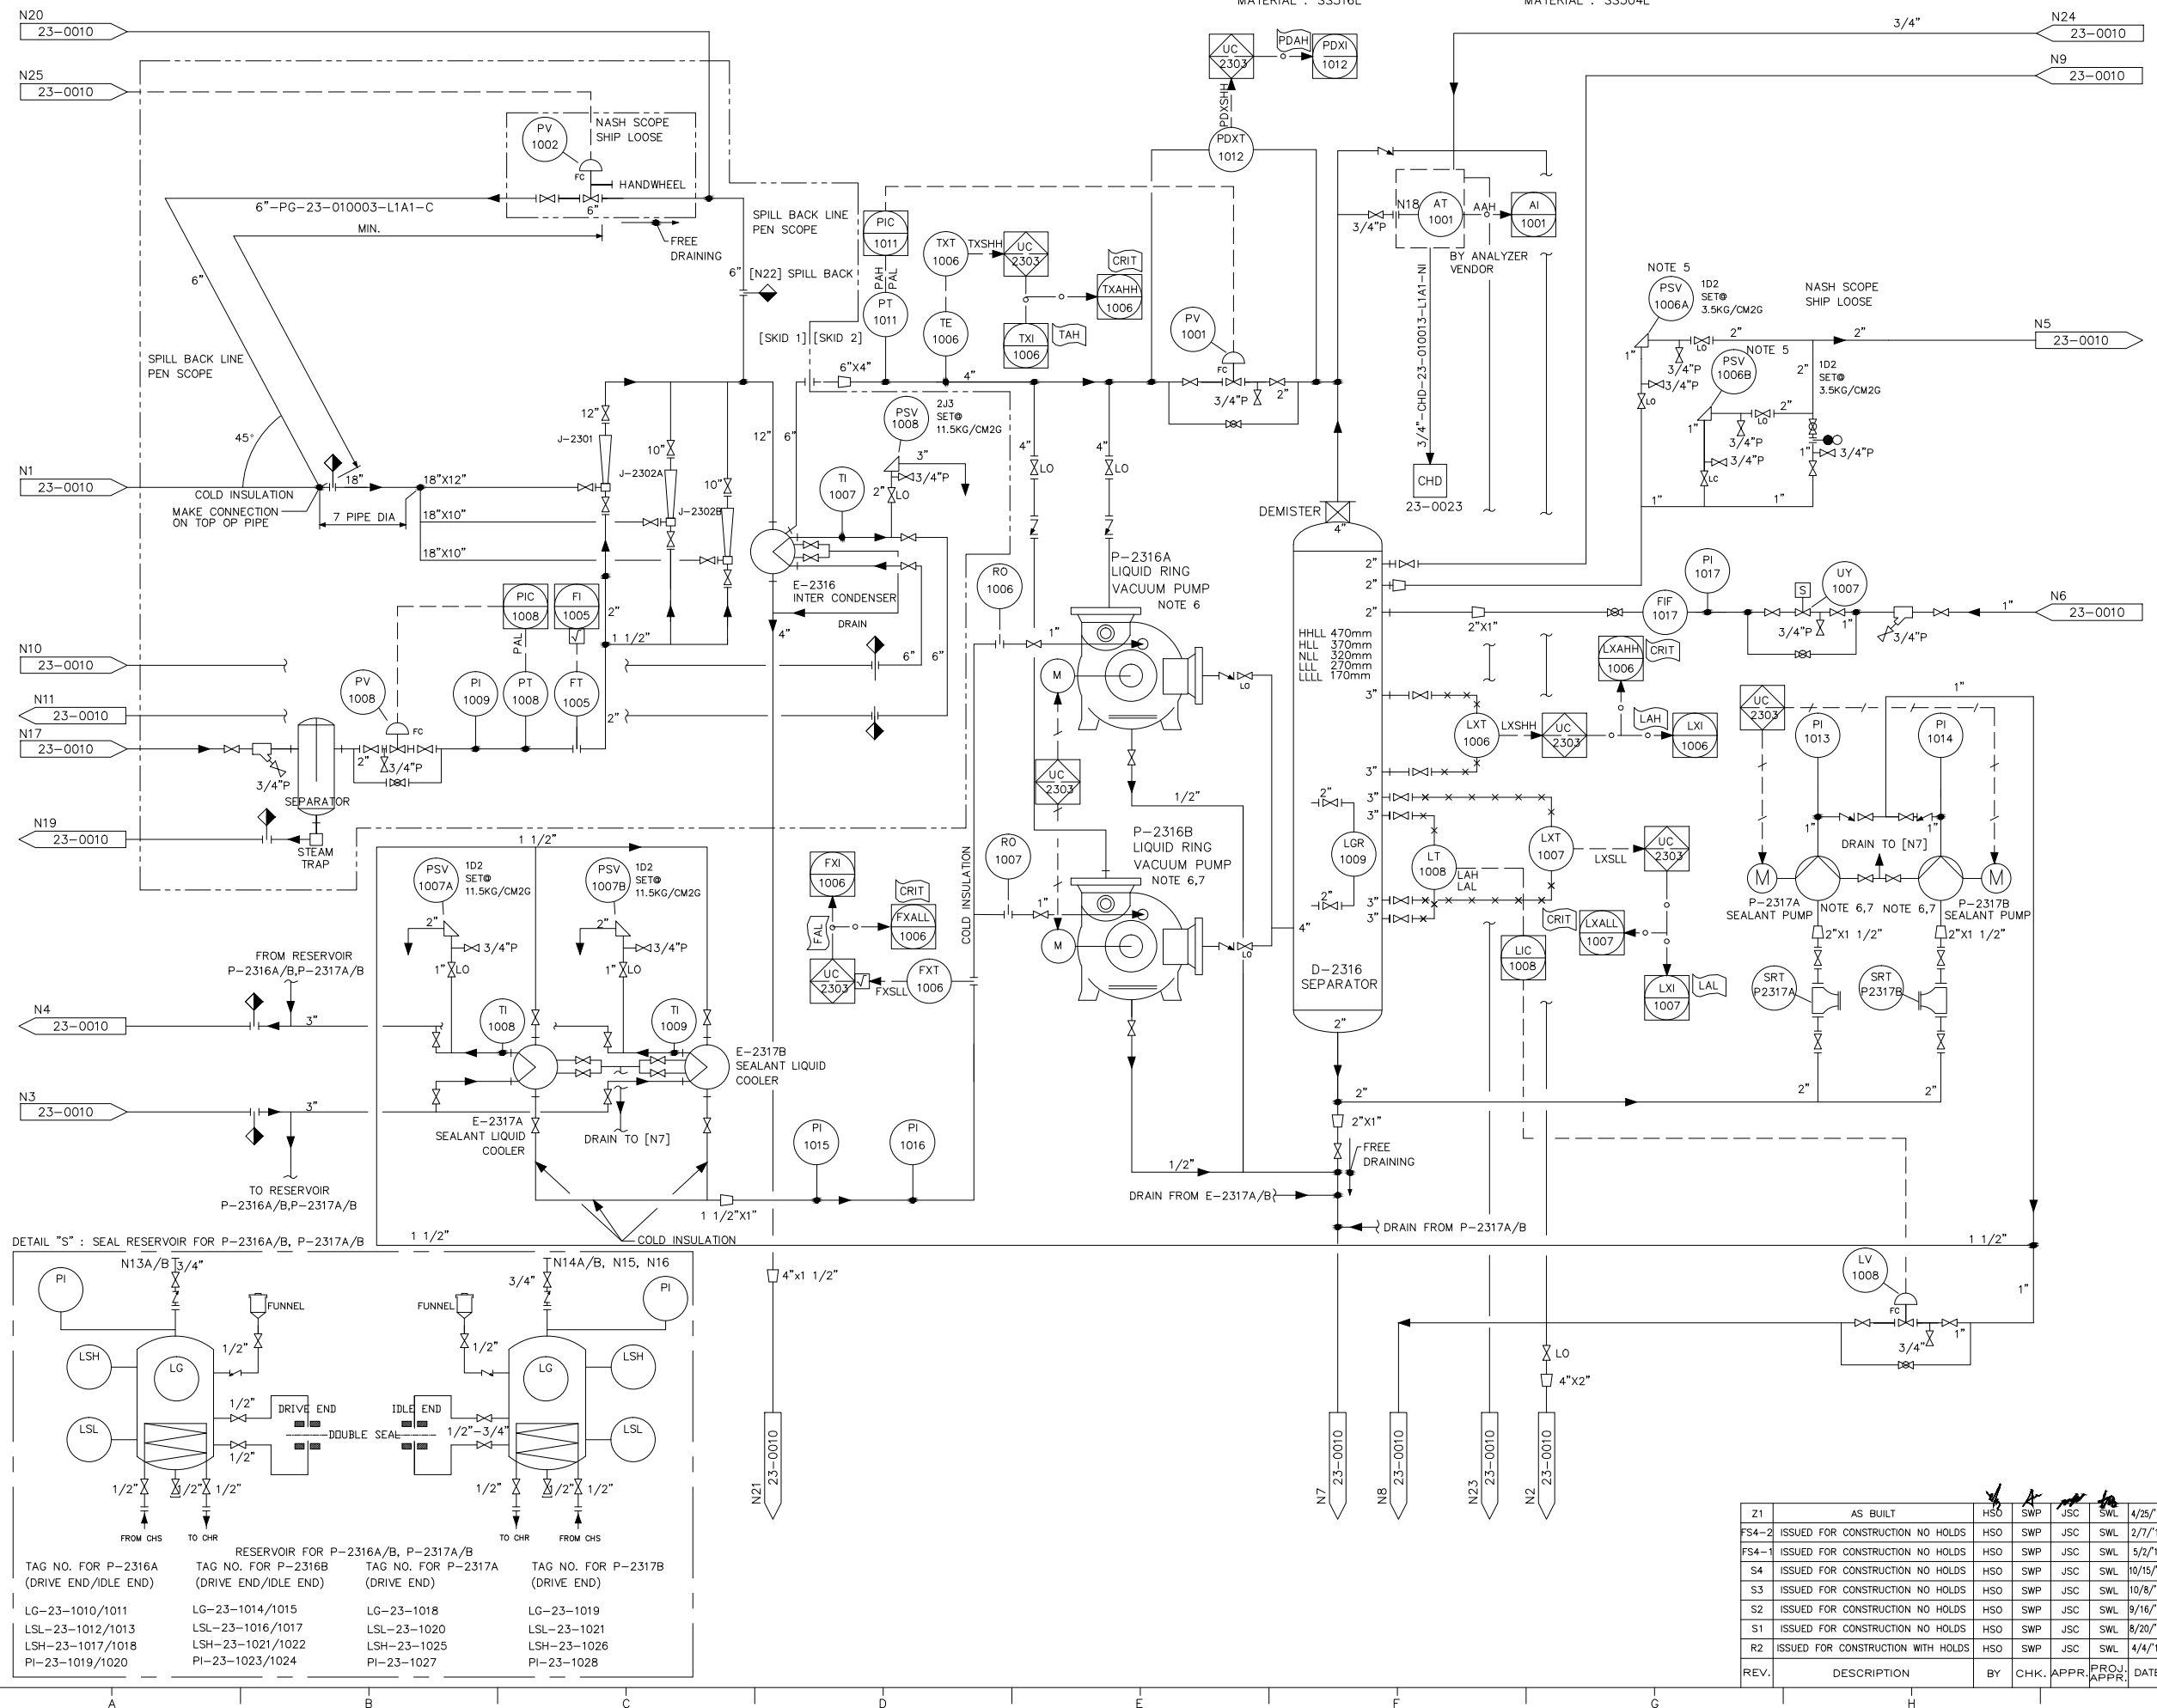

REV.	DESCRIPTION	BY	CHK.	APPR.	DATE
Z1	AS BUILT	HSO	SWP	JSC	SWL 4/25/16
FS4-2	ISSUED FOR CONSTRUCTION NO HOLDS	HSO	SWP	JSC	SWL 2/7/16
FS4-1	ISSUED FOR CONSTRUCTION NO HOLDS	HSO	SWP	JSC	SWL 5/2/15
S4	ISSUED FOR CONSTRUCTION NO HOLDS	HSO	SWP	JSC	SWL 10/15/14
S3	ISSUED FOR CONSTRUCTION NO HOLDS	HSO	SWP	JSC	SWL 10/8/14
S2	ISSUED FOR CONSTRUCTION NO HOLDS	HSO	SWP	JSC	SWL 9/16/14
S1	ISSUED FOR CONSTRUCTION NO HOLDS	HSO	SWP	JSC	SWL 8/20/14
R2	ISSUED FOR CONSTRUCTION WITH HOLDS	HSO	SWP	JSC	SWL 4/4/14

THIS DRAWING IS CONFIDENTIAL PROPERTY OF PTT PHENOL COMPANY LIMITED

AND IS LENT WITHOUT CONSIDERATION OTHER THAN THE BORROWER'S AGREEMENT THAT IT SHALL NOT BE RE-PRODUCED, COPIED, LENT, OR DISPOSED OF DIRECTLY OR INDIRECTLY NOR USED FOR ANY PURPOSE OTHER THAN THAT FOR WHICH IT IS SPECIFICALLY FURNISHED. THE APPARATUS SHOWN IN THE DRAWING MAY BE COVERED BY PATENTS AND/OR MAY BE PROPRIETARY

BASED ON 963766-120-10-A1

PIPING AND INSTRUMENT DIAGRAM
CONCENTRATION VACUUM PRODUCING EQUIPMENT (2/2)
CONCENTRATION, DECOMPOSITION AND NEUTRALIZATION
SECTION UOP PHENOL PROCESS UNIT

BY	DATE	DWG.	DSGN.	CHK.	APPR.
PEN	120117				

PROJ. NO. 14780-8120-25-23-0010A

REV. Z1

SCALE

70
65
60
0