


THESE P AND I DIAGRAM IS DIAGRAMATIC ONLY. DESIGN OF PIPE LINES MUST BE INVESTIGATED FOR VENTING OF GAS AND VAPOR POCKETS IN PIPING AND EQUIPMENT. LOW POINTS IN PIPING, PUMPS AND EQUIPMENT FOR FREEZING AND DRAINING, AND ACCESSIBILITY OF ALL VALVES, FLANGES, INSTRUMENTS INCLUDING THERMOCOUPLES, ETC.

ITEM No. : E-2307A/B (PARALLEL)
SERVICE : DECOMPOSER COOLER
DESIGN DUTY : 18.59 x 1.10 MMKcal/hr
SIZE(DIA/TUBE LENGTH / H.T.SURFACE) : 1600 mm / 6096 mm / 801.7 m²
SHELL DESIGN PRESS. AND TEMP. : 13 kg/cm²g / 120°C
TUBE DESIGN PRESS. AND TEMP. : FV, 16.5 kg/cm²g / 79°C, 250°C
INSULATION (S/T) : NI / PP(25)

1. FOR ABBREVIATIONS, SYMBOLS & GENERAL NOTES,
REFER TO LEGEND SHEETS 14780-8120-25-00-0001A
THRU 0004
2. ALL INSTRUMENTS AND PIPING SPECIALTY ITEMS ON
THIS DRAWING WILL BE PREFIXED BY UNIT NO. 2300.
3. FOR UNIT SPECIFIC DETAILS AND NOTES,
REFER TO DWG. 14780-8120-25-23-0001.
4. FOR DETAILS OF CONTROL VALVE WELL & DRAIN,
REFER TO DWG. 14780-8120-25-23-0001A.
5. FOR DETAILS OF LEVEL INSTRUMENT WELL & DRAIN,
REFER TO DWG. 14780-8120-25-23-0001B.
6. FOR DETAILS OF PUMP WELL & DRAIN,
REFER TO DWG. 14780-8120-25-23-0001C.
7. FOR DETAILS OF SAMPLING SYSTEM,
REFER TO DWG. 14780-8120-25-23-0001D
THRU 0001E.
8. FOR DETAILS OF PUMP AUXILIARY LINE, MOTOR
CONTROL AND SEAL PLAN, REFER TO
DWG. 14780-8120-25-23-0001F THRU 0001K.

NOTES

1. PIPING AND EQUIPMENT VOLUME FOR THIS DRAWING IS SUBJECT TO RESIDENCE TIME RESTRICTION.
SEE PROJECT SPECIFICATION 963766-840 FOR DETAILS
2. INLET AND OUTLET PIPING HAS BEEN SYMMETRICAL.
3. AT-23-1701 DRAIN WILL BE COLLECTED TO PORTABLE CONTAINER.
4. FOR DETAIL "XX" SEE DWG NO.
14780-8120-25-23-0001.
5. FOR DETAIL OF MOTOR CONTROL SEE DWG NO.
14780-8120-25-23-0001F "TYPE D"
6. FOR DETAIL OF SEAL PLANT, SEE DWG NO.
14780-8120-25-23-0001~L

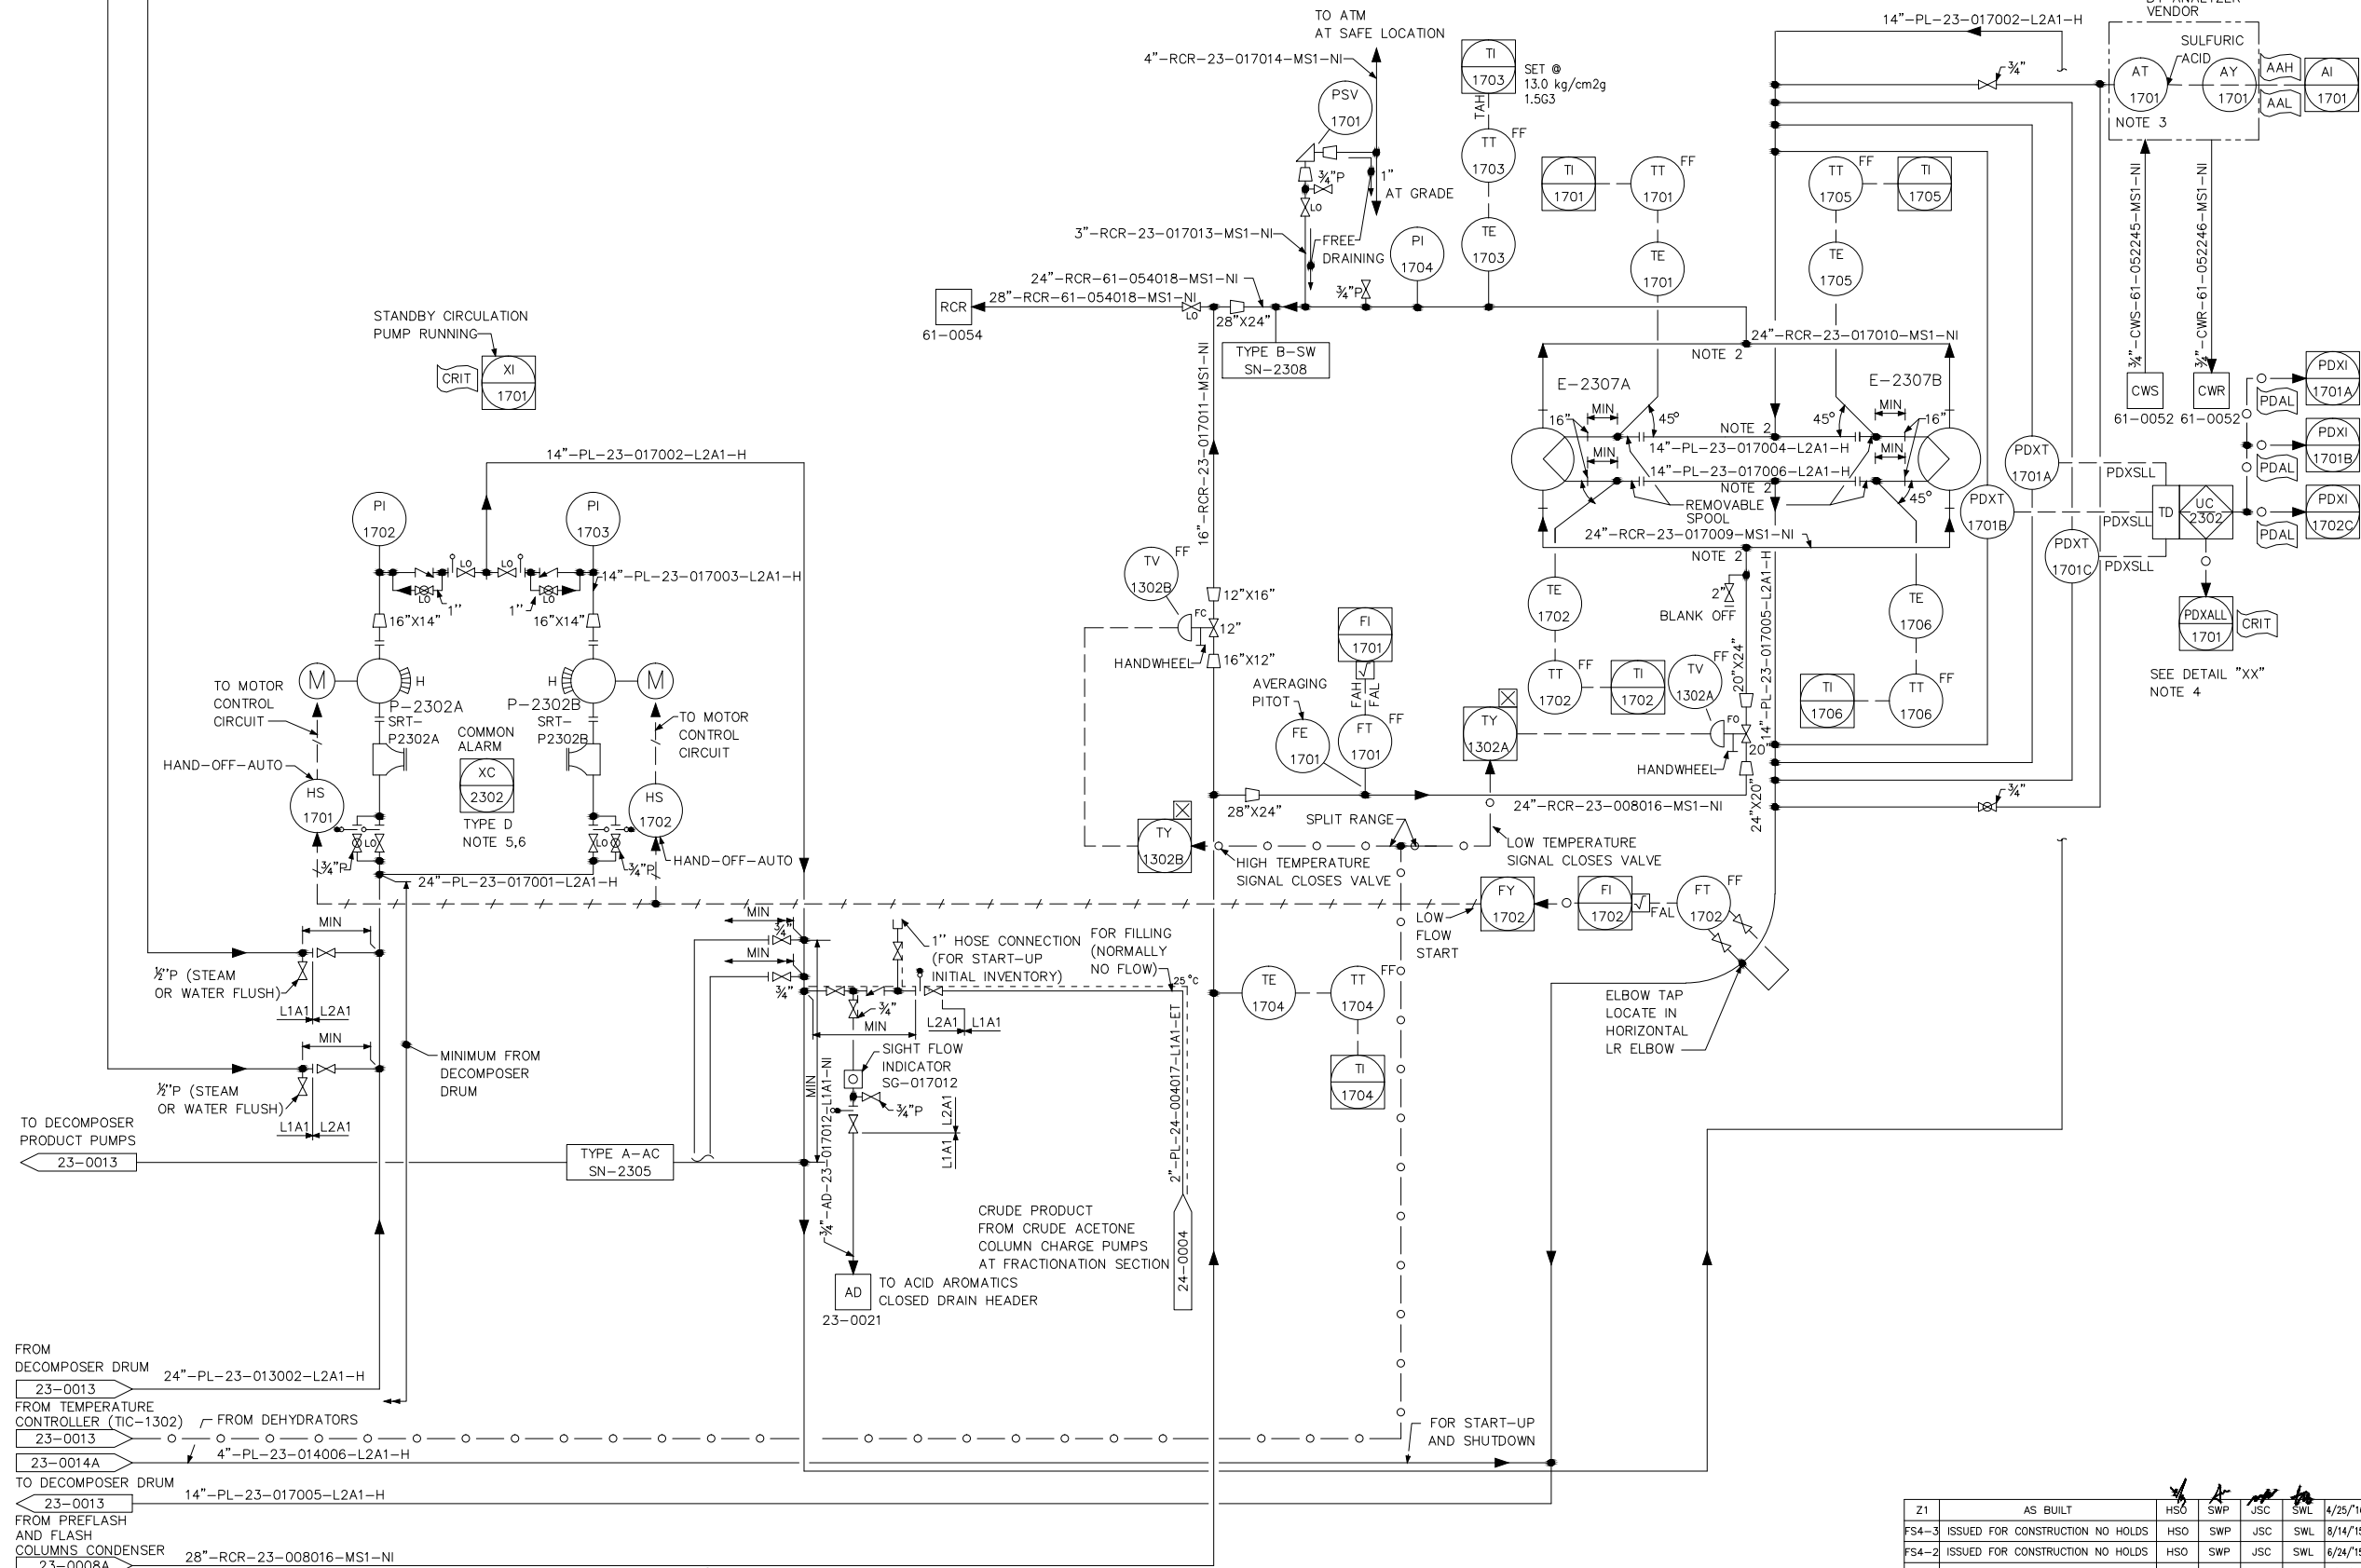

THIS DRAWING IS CONFIDENTIAL PROPERTY OF
PTT PHENOL COMPANY LIMITED

AND IS LENT WITHOUT CONSIDERATION OTHER THAN THE BORROWER'S AGREEMENT
THAT IT SHALL NOT BE RE-PRODUCED, COPIED, LENT, OR DISPOSED OF DIRECTLY OR
INDIRECTLY NOR USED FOR ANY PURPOSE OTHER THAN THAT FOR WHICH IT IS
SPECIFICALLY FURNISHED, THE APPARATUS SHOWN IN THE DRAWING MAY BE COVERED
BY PATENTS AND/OR MAY BE PROPRIETARY

Uop | BASED ON 963766-120-17-A1

PIPING AND INSTRUMENT DIAGRAM
DECOMPOSER CIRCULATION CONCENTRATION,
DECOMPOSITION, AND NEUTRALIZATION SECTION
UOP PHENOL PROCESS UNIT

Z1	AS BUILT	HSO	SWP	JSC	SWL	4/25/15
FS4-3	ISSUED FOR CONSTRUCTION NO HOLDS	HSO	SWP	JSC	SWL	8/14/15
FS4-2	ISSUED FOR CONSTRUCTION NO HOLDS	HSO	SWP	JSC	SWL	6/24/15
FS4-1	ISSUED FOR CONSTRUCTION NO HOLDS	HSO	SWP	JSC	SWL	6/18/15
S4	ISSUED FOR CONSTRUCTION NO HOLDS	HSO	SWP	JSC	SWL	10/15/15
S3	ISSUED FOR CONSTRUCTION NO HOLDS	HSO	SWP	JSC	SWL	10/8/15
S2	ISSUED FOR CONSTRUCTION NO HOLDS	HSO	SWP	JSC	SWL	9/16/15
S1	ISSUED FOR CONSTRUCTION NO HOLDS	HSO	SWP	JSC	SWL	8/20/15
REV.	DESCRIPTION	BY	CHK.	APPR.	PROJ. APPR.	DATE

CERTIFIED FOR CONSTRUCTION		BY _____ DATE _____	DWG.	DSGN.	CHK.	APPR.
BY _____ DATE _____			BY _____ DATE _____			
PROJ. NO.		DWG. NO.				REV.
PEN	120117					Z1
PPCL	14780-8120-25-23-0017					

SCALE