


ITEM No. : D-2306
SERVICE : ACID AROMATICS KNOCKOUT DRUM
SIZE DIAMETER X LENGTH(T/T) : 3400 mm x 5200 mm
DESIGN PRESS. AND TEMP. : FV. 3.5 kg/cm2g / 250 °C. 325 °C
OPERATING PRESS. AND TEMP. : 0.01 kg/cm2g / 38 °C
INSULATION : NI
MISC CONNS : F-23-020018-L1A1-NI

GENERAL NOTES

1. FOR ABBREVIATIONS, SYMBOLS & GENERAL NOTES,
REFER TO LEGEND SHEETS 14780-8120-25-00-0001A
THRU 0004.
2. ALL INSTRUMENTS AND PIPING SPECIALTY ITEMS ON
THIS DRAWING WILL BE PREFIXED BY UNIT NO. 2300.
3. FOR UNIT SPECIFIC DETAILS AND NOTES,
REFER TO DWG. 14780-8120-25-23-0001.
4. FOR DETAILS OF CONTROL VALVE VENT & DRAIN,
REFER TO DWG. 14780-8120-25-23-0001A.
5. FOR DETAILS OF LEVEL INSTRUMENT VENT & DRAIN,
REFER TO DWG. 14780-8120-25-23-0001B.
6. FOR DETAILS OF PUMP VENT & DRAIN,
REFER TO DWG. 14780-8120-25-23-0001C.
7. FOR DETAILS OF SAMPLING SYSTEM,
REFER TO DWG. 14780-8120-25-23-0001D
THRU 0001E.
8. FOR DETAILS OF PUMP AUXILIARY LINE, MOTOR
CONTROL AND SEAL PLAN, REFER TO
DWG. 14780-8120-25-23-0001F THRU 0001K.

NOTES

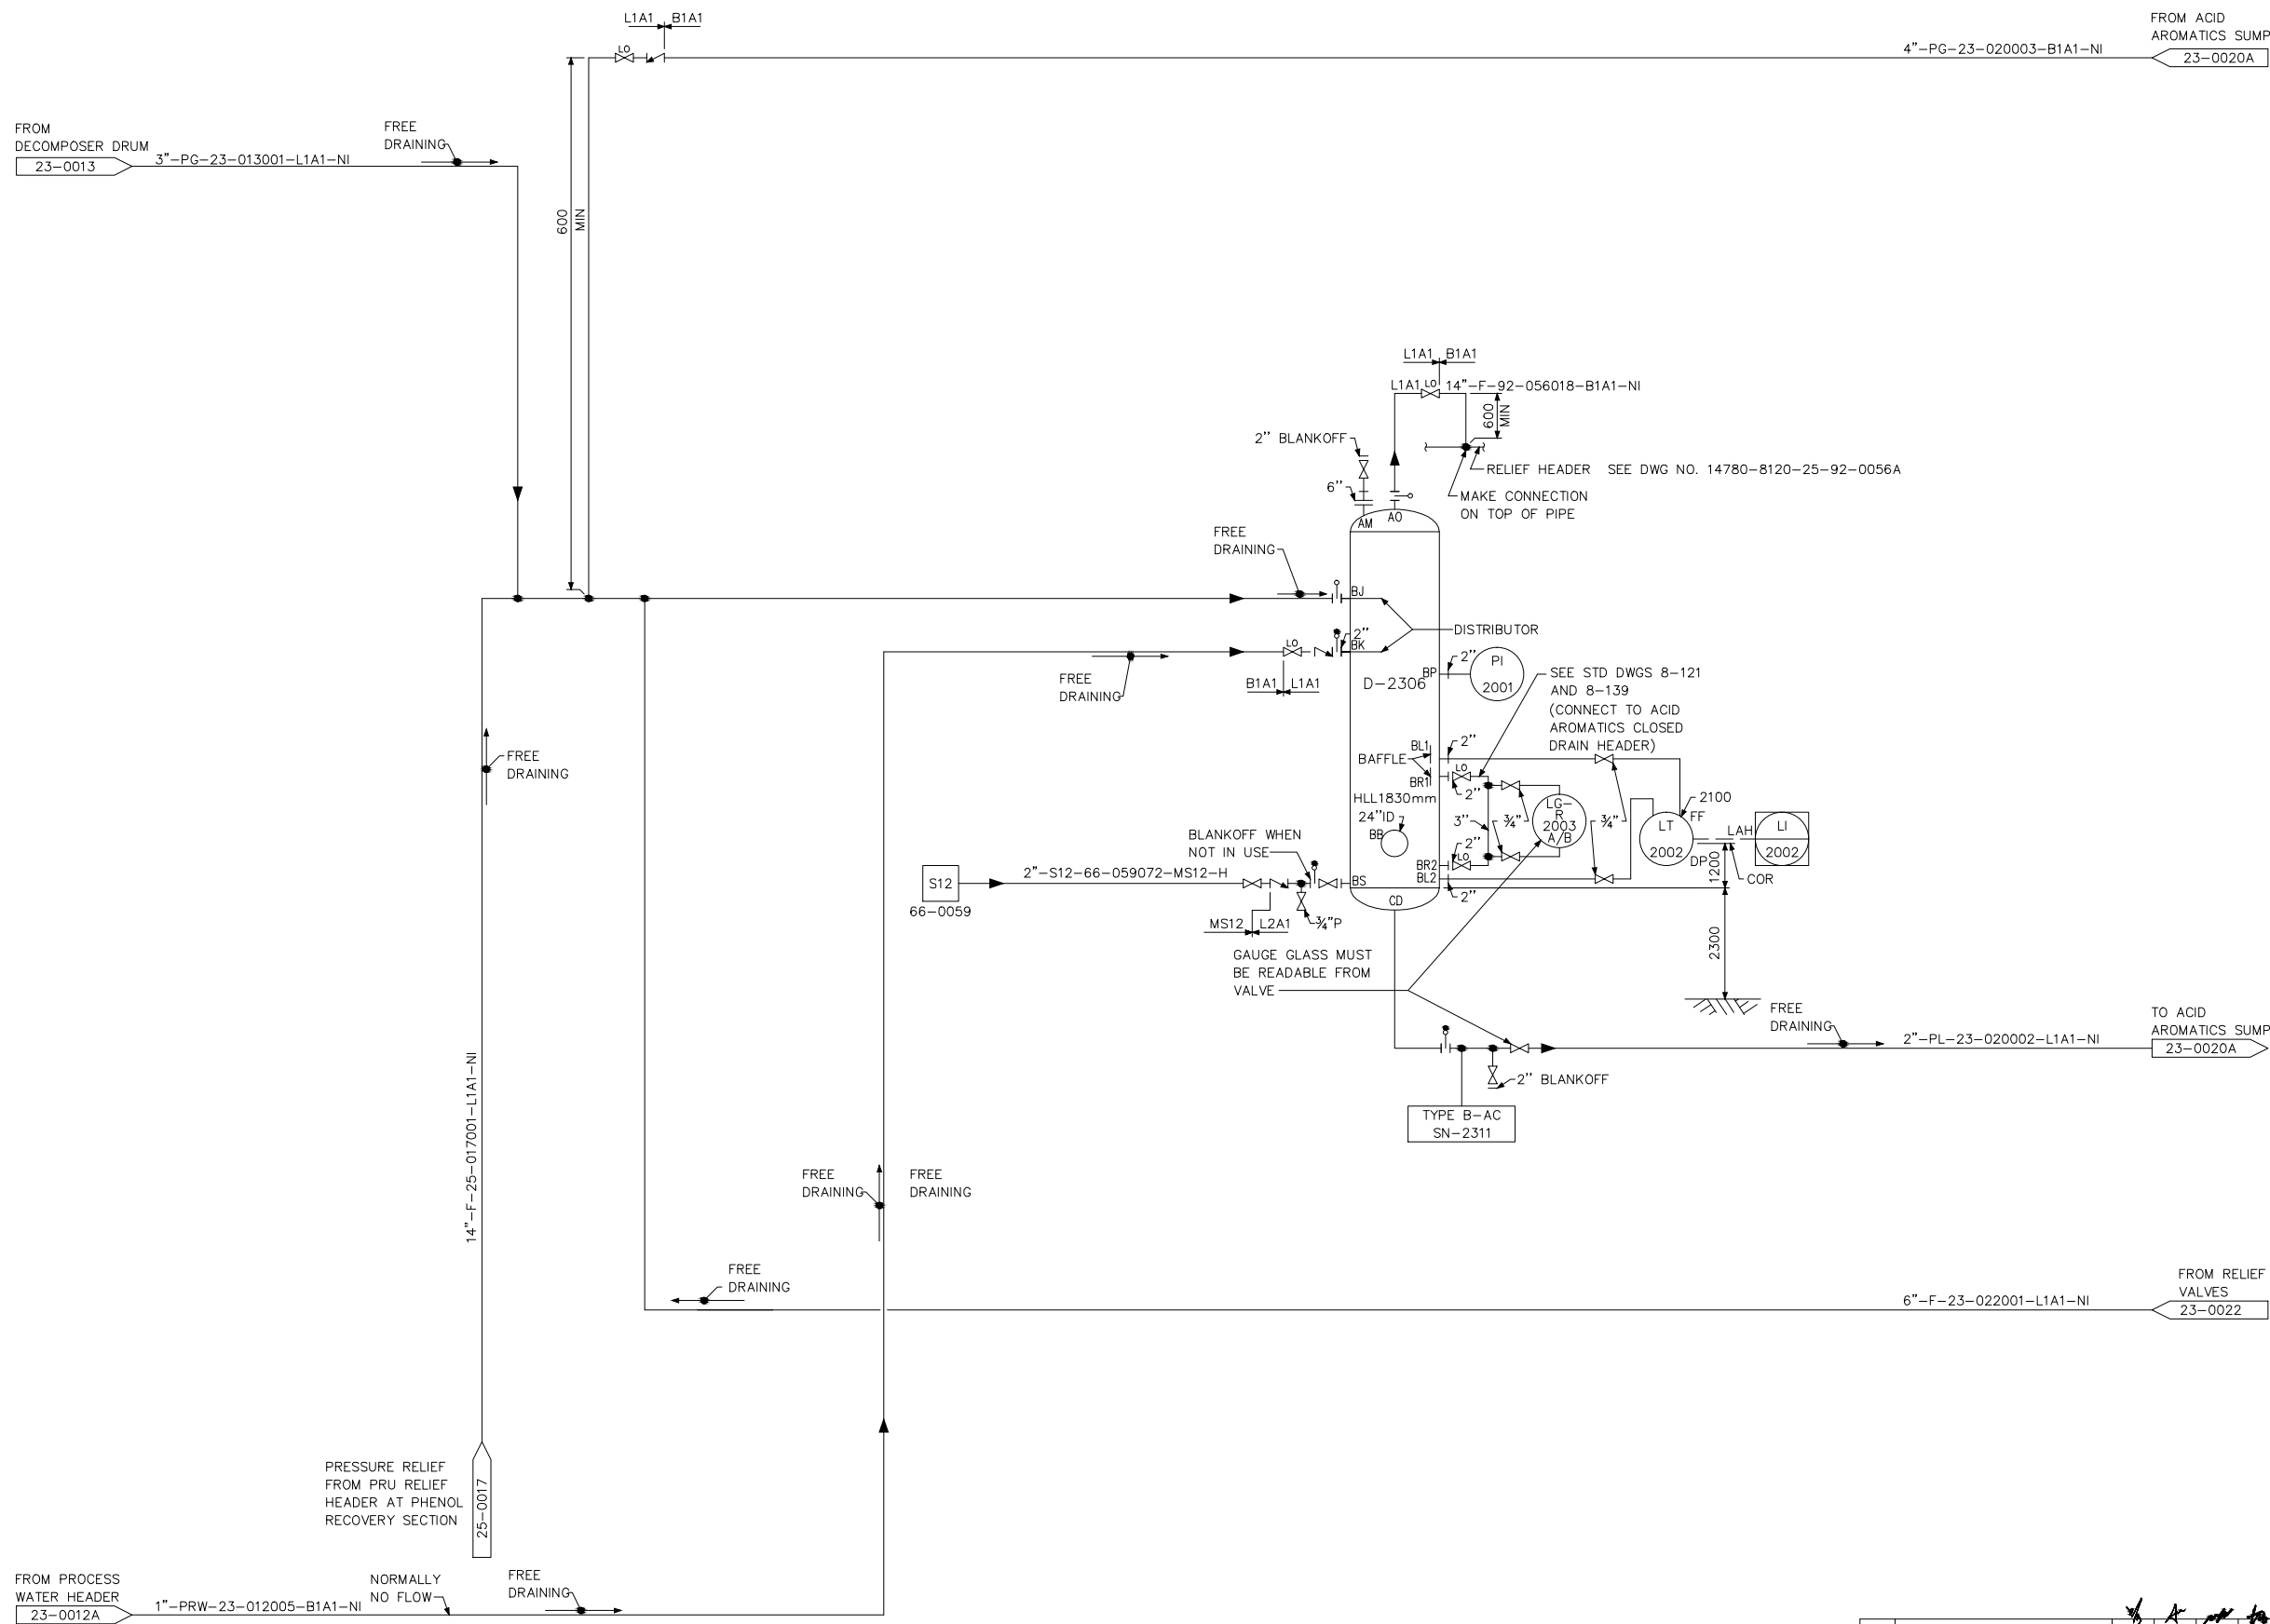

THIS DRAWING IS CONFIDENTIAL PROPERTY OF
PTT PHENOL COMPANY LIMITED

AND IS LENT WITHOUT CONSIDERATION OTHER THAN THE BORROWER'S AGREEMENT THAT IT SHALL NOT BE RE-PRODUCED, COPIED, LENT, OR DISPOSED OF DIRECTLY OR INDIRECTLY NOR USED FOR ANY PURPOSE OTHER THAN THAT FOR WHICH IT IS SPECIFICALLY FURNISHED. THE APPARATUS SHOWN IN THE DRAWING MAY BE COVERED BY PATENTS AND/OR MAY BE PROPRIETARY

Uop

BASED ON 963766-120-20-A1

PIPING AND INSTRUMENT DIAGRAM
ACID AROMATICS KNOCKOUT DRUM CONCENTRATION,
DECOMPOSITION, AND NEUTRALIZATION SECTION
UOP PHENOL PROCESS UNIT

Z1	AS BUILT	HSD	SWP	JSC	SWL	4/25/16
S4	ISSUED FOR CONSTRUCTION NO HOLDS	HSD	SWP	JSC	SWL	10/15/14
S3	ISSUED FOR CONSTRUCTION NO HOLDS	HSD	SWP	JSC	SWL	10/8/14
S2	ISSUED FOR CONSTRUCTION NO HOLDS	HSD	SWP	JSC	SWL	9/16/14
S1	ISSUED FOR CONSTRUCTION NO HOLDS	HSD	SWP	JSC	SWL	8/20/14
R2	ISSUED FOR CONSTRUCTION WITH HOLDS	HSD	SWP	JSC	SWL	4/4/14
R1	ISSUED FOR CONSTRUCTION WITH HOLDS	HSD	SWP	JSC	SWL	2/28/14
A2	APPROVED FOR DESIGN	HSD	SWP	JSC	SWL	2/7/14
REV.	DESCRIPTION	BY	CHK.	APPR.	PRO-APPR.	DATE

CERTIFIED FOR CONSTRUCTION

	DWG.	DSGN.	CHK.	APPR.
--	------	-------	------	-------

BY _____

BY				
----	--	--	--	--

DATE _____

DATE				
------	--	--	--	--

	PROJ. N
--	---------

DWG. NO.	REV.
----------	------

PEN | 12011

[illegible]

PPCL	14
------	----

20-25-23-0020

SCALE