


DECOMPOSER FEED
FLUSH DRUM
D-2303

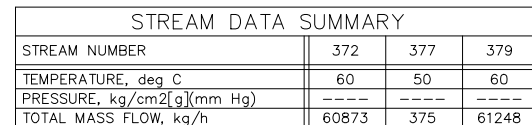

AND IS LENT WITHOUT CONSIDERATION OTHER THAN THE BORROWER'S AGREEMENT THAT IT SHALL NOT BE RE-PRODUCED, COPIED, LENT, OR DISPOSED OF DIRECTLY OR INDIRECTLY NOR USED FOR ANY PURPOSE OTHER THAN THAT FOR WHICH IT IS SPECIFICALLY FURNISHED. THE APPARATUS SHOWN IN THE DRAWING MAY BE COVERED BY PATENTS AND/OR MAY BE PROPRIETARY.

BASED ON 963766-110-04-A1

CERTIFIED FOR CONSTRUCTION		DWG.	DSGN.	CHK.	APP.
-------------------------------	--	------	-------	------	------

DATE _____	DATE				
------------	------	--	--	--	--

3	PEN	120117		
---	-----	--------	--	--

13			Z1
	DDOI	1 1780 9180 00 07 0001	

PPCL	14780-8120-20-23-0004	
------	-----------------------	--

SCALE

SCALE

										CONCENTRATION, DECOMPOSITION AND NEUTRALIZATION SECTION							
										UOP PHENOL PROCESS UNIT							
										CERTIFIED FOR CONSTRUCTION			DWG.	DSGN.	CHK.	APP.	
										BY _____			BY				
										DATE _____			DATE				
Z1	AS-BUILT				HSO	SWP	JSC	SWL	4/25/16								
S1	ISSUED FOR CONSTRUCTION NO HOLDS				HSO	SWP	JSC	SWL	4/25/14	PROJ. NO.		DWG. NO.		REV.			
A1	APPROVED FOR DESIGN				HSO	SWP	JSC	SWL	8/12/13	PEN	120117			Z1			
O1	COMMENT ISSUE				HSO	SWP	JSC	SWL	7/1/13								
REV.	DESCRIPTION				BY	CHK.	APPR.	PROJ. APPR.	DATE	PPCL	14780-8120-20-23-0004						