

THESE P AND I DIAGRAM IS DIAGRAMATIC ONLY. DESIGN OF PIPE LINES MUST BE INVESTIGATED FOR VENTING OF GAS AND VAPOR POCKETS IN PIPING AND EQUIPMENT. LOW POINTS IN PIPING, PUMPS AND EQUIPMENT FOR FREEZING AND DRAINING, AND ACCESSIBILITY OF ALL VALVES, FLANGES, INSTRUMENTS INCLUDING THERMOCOUPLES, ETC.

ITEM No. : D-2312
SERVICE : DIAMINE INJECTION TANK
SIZE DIAMETER x LENGTH (T/T) : 1300 mm x 1300 mm
DESIGN PRESSURE AND TEMP. : 3.5 kg/cm2g / 120°C
OPERATING PRESSURE AND TEMP. : 0.01 kg/cm2g / 40°C
INSULATION : NI

ITEM No. : P-2306A/B
SERVICE : NEUTRALIZING AGENT INJECTION PUMPS
SPECIFIC GRAVITY @ PUMPING TEMP. : 0.856
DESIGN CAPACITY : 6.65 liter/h
DIFFERENTIAL PRESS. : 4.78 kg/cm2
MOTOR POWER : 0.2 kW
INSULATION : NI

ITEM No. : X-2310A/B
SERVICE : DIRECT NEUTRALIZATION STATIC MIXERS
SIZE DIAMETER X LENGTH(T/T) : 6" SCH 40 x 1420mm
DESIGN PRESS. AND TEMP. : 21.5 kg/cm2g / 250°C
OPERATING PRESS. AND TEMP. : 4.4 kg/cm2g / 43 °C
INSULATION : NI

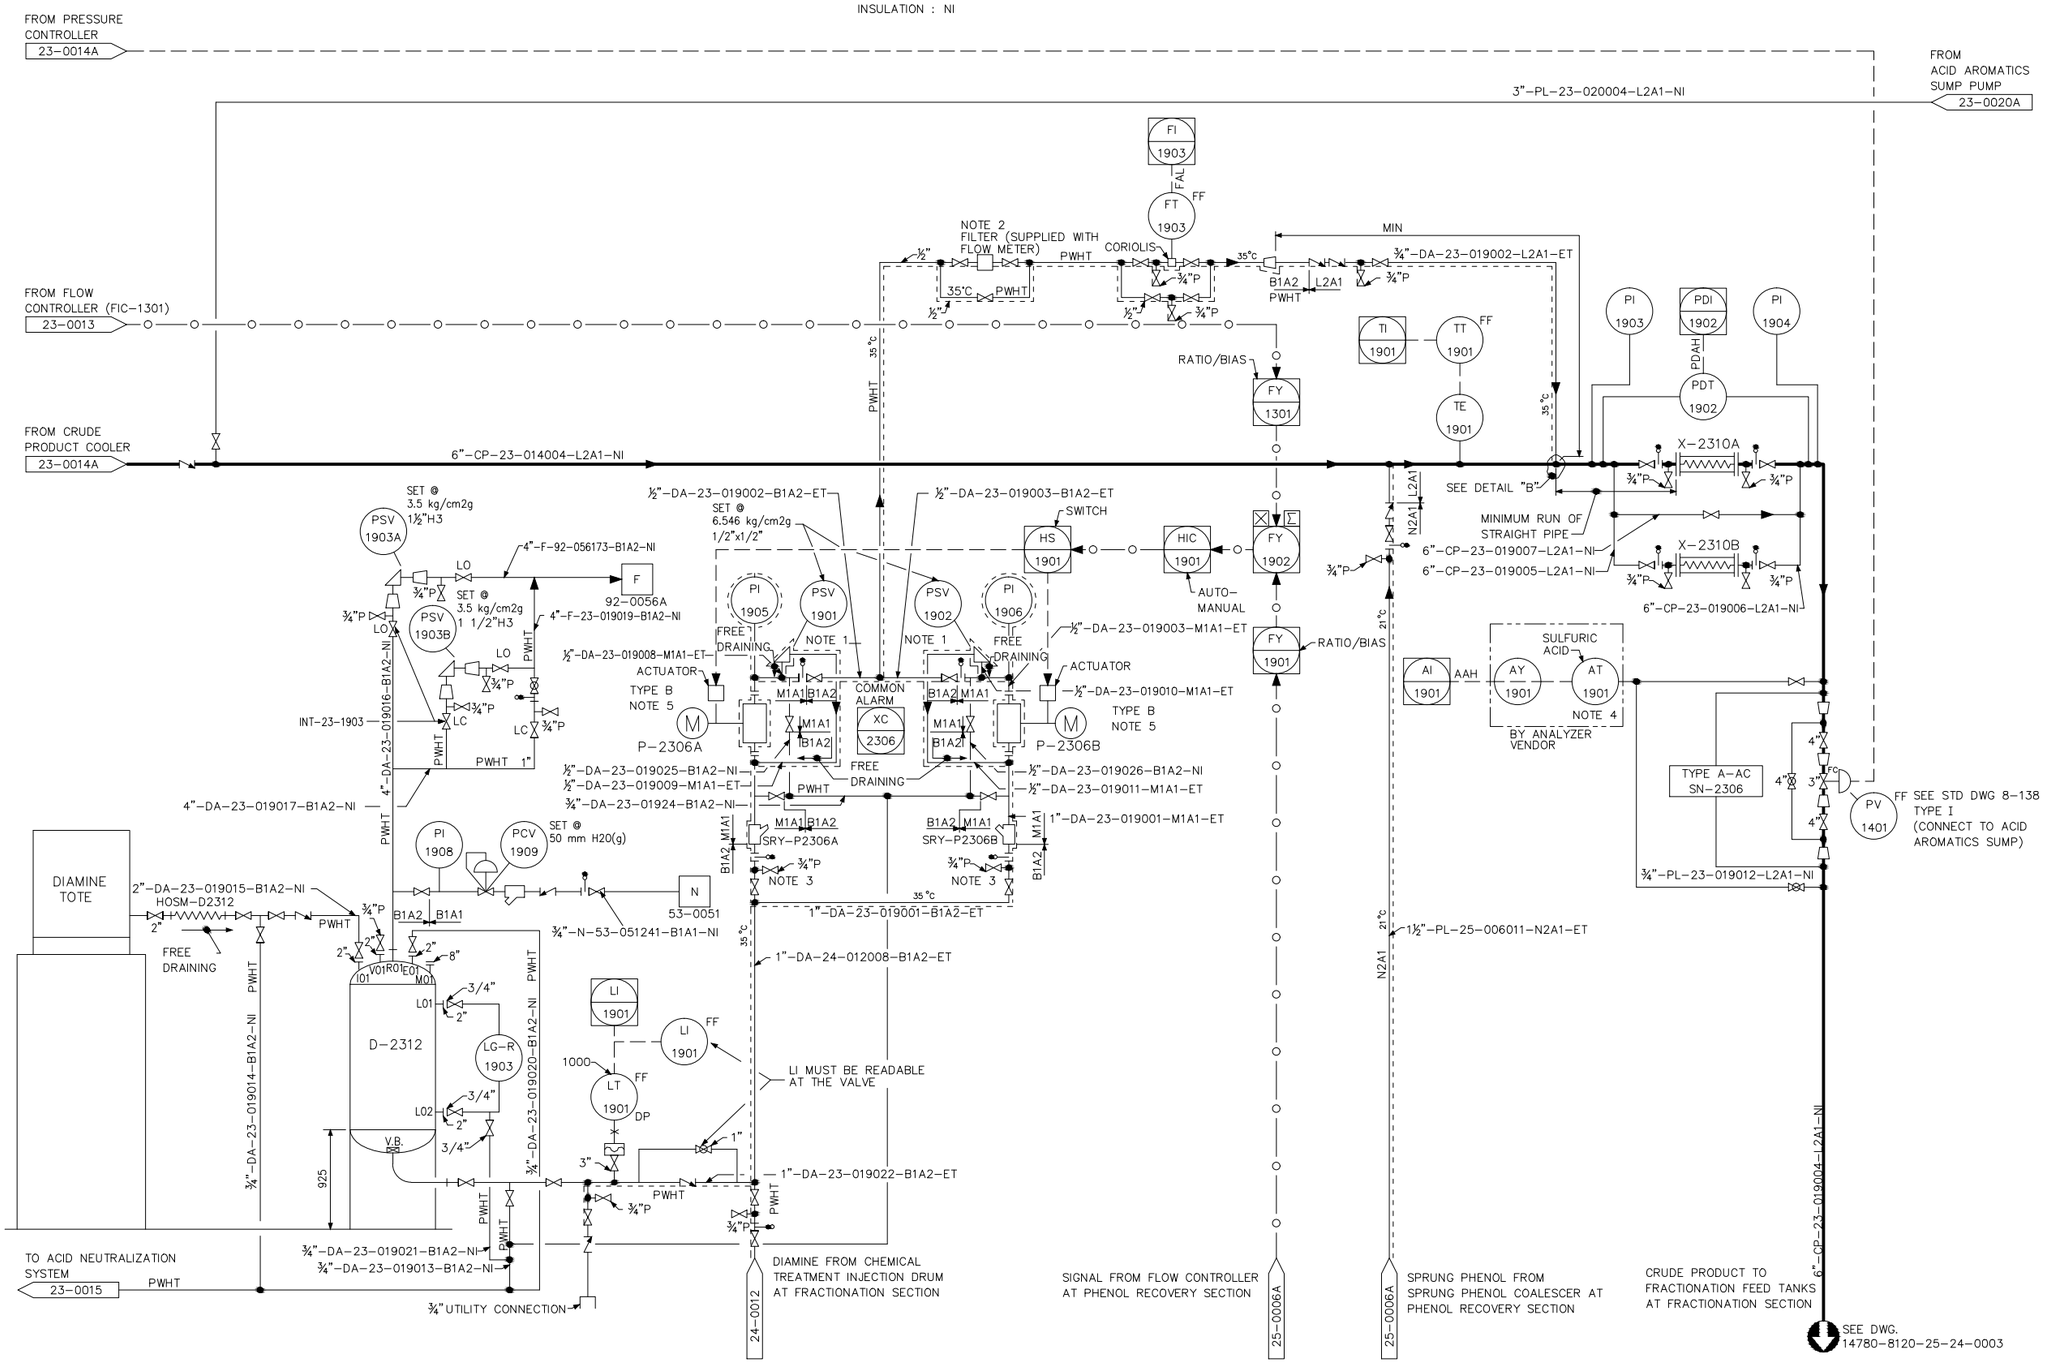

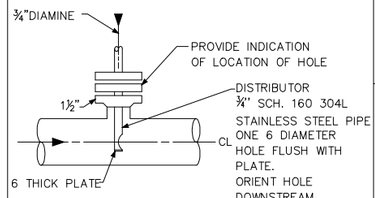

DETAIL "B"

INSTALL NOZZLE IN HORIZONTAL LINE, ON TOP OR SIDE

GENERAL NOTES

1. FOR ABBREVIATIONS, SYMBOLS & GENERAL NOTES, REFER TO LEGEND SHEETS 14780-8120-25-00-0001A THRU 0004
2. ALL INSTRUMENTS AND PIPING SPECIALTY ITEMS ON THIS DRAWING WILL BE PREFIXED BY UNIT NO. 2300.
3. FOR UNIT SPECIFIC DETAILS AND NOTES, REFER TO DWG. 14780-8120-25-23-0001.
4. FOR DETAILS OF CONTROL VALVE VENT & DRAIN, REFER TO DWG. 14780-8120-25-23-0001A.
5. FOR DETAILS OF LEVEL INSTRUMENT VENT & DRAIN, REFER TO DWG. 14780-8120-25-23-0001B.
6. FOR DETAILS OF PUMP VENT & DRAIN, REFER TO DWG. 14780-8120-25-23-0001C.
7. FOR DETAILS OF SAMPLING SYSTEM, REFER TO DWG. 14780-8120-25-23-0001D THRU 0001E.
8. FOR DETAILS OF PUMP AUXILIARY LINE, MOTOR CONTROL AND SEAL PLAN, REFER TO DWG. 14780-8120-25-23-0001F THRU 0001K.

NOTES

1. RELIEF VALVES SHALL BE SUPPLIED BY PUMP VENDOR
2. FILTER TO PREVENT PARTICLE >0.5mm FROM PLUGGING IN FLOWMETER.
3. FOR CALIBRATION CONNECTION.
4. AT-23-1901 DRAIN WILL BE CONNECTED TO PORTABLE CONTAINER.
5. FOR DETAIL OF MOTOR CONTROL SEE DWG NO. 14780-8120-25-23-0001F "TYPE B"
6. KEY INTERLOCKED ON OPERATING SET OF VALUES FOR LOCKED OPEN SHALL BE PROVIDED ON INLET SIDE.

REV.	DESCRIPTION	BY	CHK.	APPR.	PROJ. APPR.	DATE
Z1	AS BUILT	HSO	SWP	JSC	SWL	4/25/16
FS4-1	ISSUED FOR CONSTRUCTION NO HOLDS	HSO	SWP	JSC	SWL	8/3/15
S4	ISSUED FOR CONSTRUCTION NO HOLDS	HSO	SWP	JSC	SWL	10/15/14
S3	ISSUED FOR CONSTRUCTION NO HOLDS	HSO	SWP	JSC	SWL	10/8/14
S2	ISSUED FOR CONSTRUCTION NO HOLDS	HSO	SWP	JSC	SWL	9/16/14
S1	ISSUED FOR CONSTRUCTION NO HOLDS	HSO	SWP	JSC	SWL	8/20/14
R2	ISSUED FOR CONSTRUCTION WITH HOLDS	HSO	SWP	JSC	SWL	4/4/14
R1	ISSUED FOR CONSTRUCTION WITH HOLDS	HSO	SWP	JSC	SWL	2/28/14

CERTIFIED FOR CONSTRUCTION
BY _____
DATE _____

	DWG.	DSGN.	CHK.	APPR.
BY				
DATE				

THIS DRAWING IS CONFIDENTIAL PROPERTY OF PTT PHENOL COMPANY LIMITED
AND IS LENT WITHOUT CONSIDERATION OTHER THAN THE BORROWER'S AGREEMENT THAT IT SHALL NOT BE RE-PRODUCED, COPIED, LENT, OR DISPOSED OF DIRECTLY OR INDIRECTLY NOR USED FOR ANY PURPOSE OTHER THAN THAT FOR WHICH IT IS SPECIFICALLY FURNISHED. THE APPARATUS SHOWN IN THE DRAWING MAY BE COVERED BY PATENTS AND/OR MAY BE PROPRIETARY

BASED ON 963766-120-19-A1

PIPING AND INSTRUMENT DIAGRAM
NEUTRALIZATION CONCENTRATION, DECOMPOSITION, AND NEUTRALIZATION SECTION
UOP PHENOL PROCESS UNIT

PROJ. NO.	DWG. NO.	REV.
PEN 120117		Z1
PPCL	14780-8120-25-23-0019	

SCALE

NOTE: THE INFORMATION IN THIS DOCUMENT IS CONFIDENTIAL AND THE PROPERTY OF UOP LLC AND MUST NOT BE DISCLOSED TO OTHERS OR REPRODUCED IN ANY MANNER OR USED FOR ANY PURPOSE WHATSOEVER WITHOUT ITS WRITTEN PERMISSION.